

CODED

Monroe
K 22
6-69

MISSISSIPPI
BOARD OF WATER COMMISSIONERS
416 North State Street
Jackson, Mississippi 39201

WATER WELL DRILLERS LOG

6-30 1969 Herndon-Homan Well & Supply, Inc. Monroe
date well completed firm name county well located
SHANNON, MISSISSIPPI 38865

LANDOWNER: Marshall Deavers
Route 3, Box 47
Aberdeen, Miss.
(mailing address)

description of formations encountered	from
<u>Sandstone sand & clay</u>	<u>0-25</u>
<u>Blue clay</u>	<u>25-180</u>
<u>Sand</u>	<u>180-300</u>
<u>Bottom</u>	<u>(M)</u>

WELL LOCATION:
sec. 3 T. 4 N. R. 6 E.
3 1/2 miles E of Egypt
(distance) (direction) (nearest town)

WELL PURPOSE: home
(home, irrigation, municipal, industrial)

- WELL COMPLETION DATA:
- (1) diameter (inches) 5"
 - (2) total depth (feet) 300'
 - (3) static water level (feet) 76 below above top of ground.
 - (4) casing Steel 32' 8"
(material) (depth)
5" if telescope see back.
(size)
 - (5) screen no
(length) (depth to top)
(size) (material)
 - (6) pump 1/2 5
(HP) (yield gpm)
Electric
(type power)
 - (7) electric log no
(yes or no)

(organization running log)
(8) how well bottom plugged open


DRILLERS REMARKS:

CODED

7 11 1969
MISS. BO. OF
WATER COMMISSIONERS

If well telescopes please sketch and show depths.

GROUND LEVEL

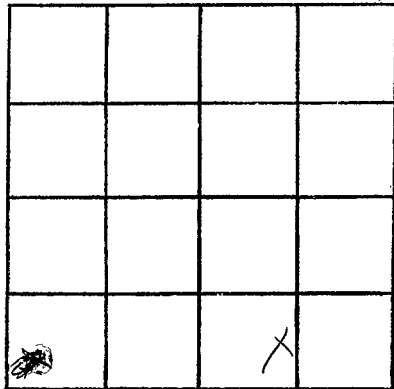

SECTION 3

Please indicate well location X.

ADDITIONAL INFORMATION

If more than one screen,
show locations of each on sketch.