

CODED

Monroe
K 23
7-69

MISSISSIPPI
BOARD OF WATER COMMISSIONERS
416 North State Street
Jackson, Mississippi 39201

WATER WELL DRILLERS LOG

7-7 1969 Herndon-Homan Well & Supply Co. Monroe
date well completed firm name Box 42 county well located
STANTON, MISSISSIPPI 38668

LANDOWNER: Calvin Clifton
Route 3 (Contracted)
Aberdeen, Miss
(mailing address)

description of formations encountered	from
Surface Soil +	
Clay	0-25
Blue Clay	25-270
Sand	270-380
Bottom	380

WELL LOCATION:
sec. 11 T. 1 N. R. 6 E
4 miles NW of Aberdeen
(distance) (direction) (nearest town)

WELL PURPOSE: home
(home, irrigation, municipal, industrial)

- WELL COMPLETION DATA:
- (1) diameter (inches) 5"
 - (2) total depth (feet) 380'
 - (3) static water level (feet) 73 below top of ground.
 - (4) casing Steel 32' (material) (depth)
5' (size) if telescope see back.
 - (5) screen no (length) (depth to top)
(size) (material)
 - (6) pump 1/2 (HP) 5 (yield gpm)
Electric (type power)
 - (7) electric log no (yes or no)


(organization running log)
(8) how well bottom plugged open

DRILLERS REMARKS:

NOV 14 1969
FRESH WATER

If well telescopes please sketch and show depths.

GROUND LEVEL

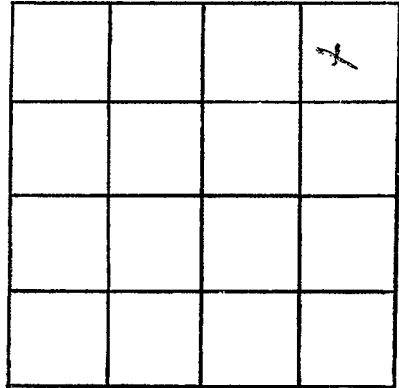

SECTION 11

Please indicate well location X.

ADDITIONAL INFORMATION

If more than one screen, show locations of each on sketch.