

**MONROE**  
 K 27  
 9-26-69

134

MISSISSIPPI  
 BOARD OF WATER COMMISSIONERS  
 416 North State Street  
 Jackson, Mississippi 39201

CODED

WATER WELL DRILLERS LOG

9-26 1969 Herndon-Homan Well Monroe  
 date well completed firm name county well located

LANDOWNER Melvin Gunn  
Route 3, Box 181  
Aberdeen, Miss.  
 (mailing address)

description of formations encountered	from	to
Surface sand & clay	0	23
Blue clay	23	320
Sand	320	460
Bottom	460	

WELL LOCATION:  
 sec. 8 T. 14 N. R. 6 E.  
2 miles N of Gibson  
 (distance) (direction) (nearest town)

WELL PURPOSE: home  
 (home, irrigation, municipal, industrial)

- WELL COMPLETION DATA:
- diameter (inches) 5"
  - total depth (feet) 460'
  - static water level (feet) 122 below above top of ground.
  - casing Steel 31'6"  
 (material) (depth)  
5" if telescope see back.  
 (size)
  - screen no  
 (length) (depth to top)  
 (size) (material)
  - pump 1/2 5  
 (HP) (yield gpm)  
Electric  
 (type power)
  - electric log no  
 (yes or no)

(organization running log)

(8) how well bottom plugged open


DRILLERS REMARKS:

NOV 21 1969

MISS. BUREAU OF  
 WATER RESOURCES

If well telescopes please sketch and show depths.

GROUND LEVEL

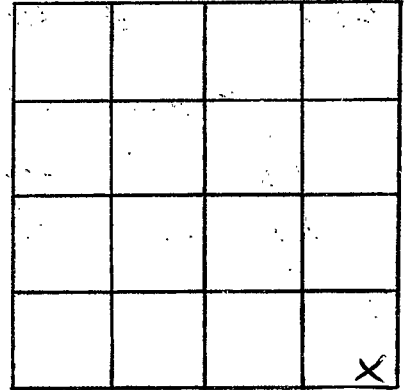

SECTION 8

Please indicate well location X.

ADDITIONAL INFORMATION

If more than one screen,  
show locations of each on sketch.