

MONROE

K 28

10-22-69

MISSISSIPPI
 BOARD OF WATER COMMISSIONERS
 416 North State Street
 Jackson, Mississippi 39201

CODED

WATER WELL DRILLERS LOG

10-22 1969 Herndon-Homan Well Monroe
 date well completed firm name county well located

LANDOWNER: Bobby Strader

description of formations encountered

from

to

Route 3
Aberdeen, Miss
 (mailing address)

description of formations encountered	from	to
<u>Surface sand & clay</u>	<u>0</u>	<u>18</u>
<u>Blue clay</u>	<u>18</u>	<u>160</u>
<u>Sand</u>	<u>160</u>	<u>300</u>
<u>Bottom</u>	<u>300</u>	

WELL LOCATION:

sec. 13 T. 14 R. 6 E
3 miles NW of Aberdeen
 (distance) (direction) (nearest town)

WELL PURPOSE: Home
 (home, irrigation, municipal, industrial)

WELL COMPLETION DATA:

- (1) diameter (inches) 5"
- (2) total depth (feet) 300'
- (3) static water level (feet) 98 below above top of ground.
- (4) casing Steel, 23'
 (material) (depth)
5" if telescope see back.
 (size)
- (5) screen 70
 (length) (depth to top)
 (size) (material)
- (6) pump 1/2 5
 (HP) (yield gpm)
Electric
 (type power)
- (7) electric log no
 (yes or no)
 (organization running log)
- (8) how well bottom plugged open


NOV 21 1969

DRILLERS REMARKS:

MISS. REG. OF
 WATER UTIL.

If well telescopes please sketch and show depths.

GROUND LEVEL

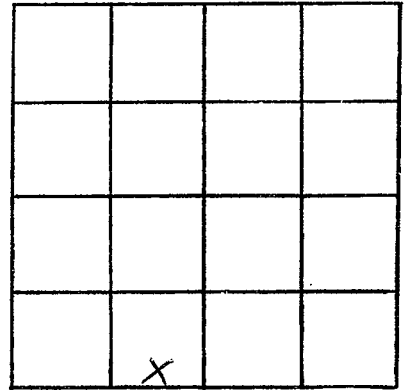

SECTION 13

Please indicate well location X.

ADDITIONAL INFORMATION

If more than one screen,
show locations of each on sketch.