

MONROE
K 29
11-12-69

MISSISSIPPI
 BOARD OF WATER COMMISSIONERS
 416 North State Street
 Jackson, Mississippi 39201

CODED

WATER WELL DRILLERS LOG

11-12 1969 Herndon Home Well & Supply, Inc. Monroe
 date well completed firm name county well located

LANDOWNER: David Holliday
Route 2
Okolona, Miss.
 (mailing address)

description of formations encountered	from	to
<u>Surface sand & clay</u>	<u>0</u>	<u>20</u>
<u>Other clay</u>	<u>20</u>	<u>300</u>
<u>Sand</u>	<u>300</u>	<u>440</u>
<u>Both</u>	<u>440</u>	

WELL LOCATION:
 sec. 7 T. 14 N. R. 6 E. W. W
1 1/2 miles SE of Egypt
 (distance) (direction) (nearest town)

WELL PURPOSE: home
 (home, irrigation, municipal, industrial)

- WELL COMPLETION DATA:
- (1) diameter (inches) 5"
 - (2) total depth (feet) 440
 - (3) static water level (feet) 115 below above top of ground.
 - (4) casing Steel 30'
 (material) (depth)
5" if telescope see back.
 (size)
 - (5) screen no
 (length) (depth to top)
 (size) (material)
 - (6) pump 1/2 5
 (HP) (yield gpm)
Electric
 (type power)
 - (7) electric log no
 (yes or no)
 - (organization running log)
 - (8) how well bottom plugged open


NOV 21 1969

DRILLERS REMARKS:

DRILLER'S SIGNATURE

If well telescopes please sketch and show depths.

GROUND LEVEL

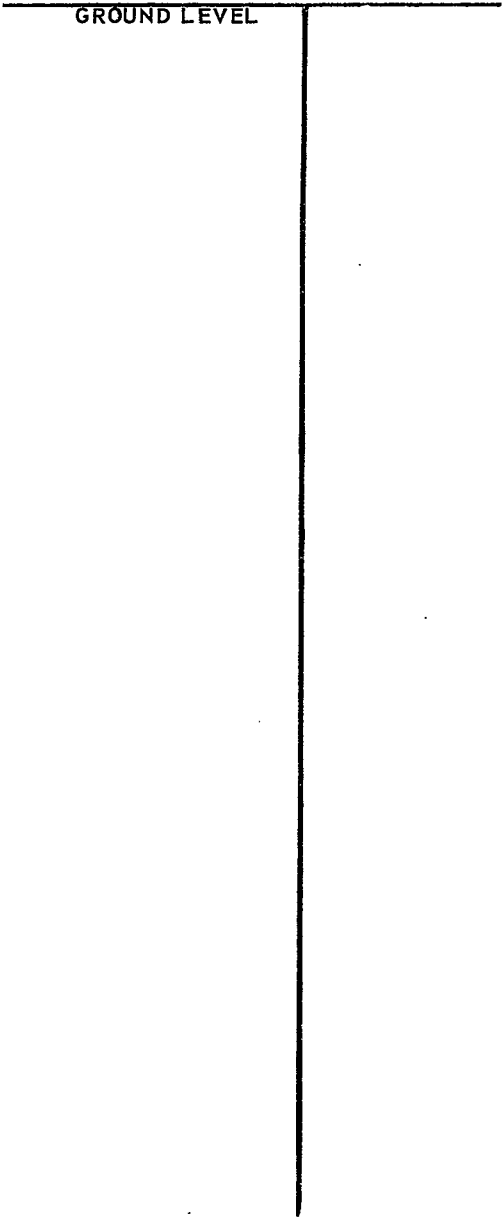


X			

SECTION 7

Please indicate well location X.

ADDITIONAL INFORMATION

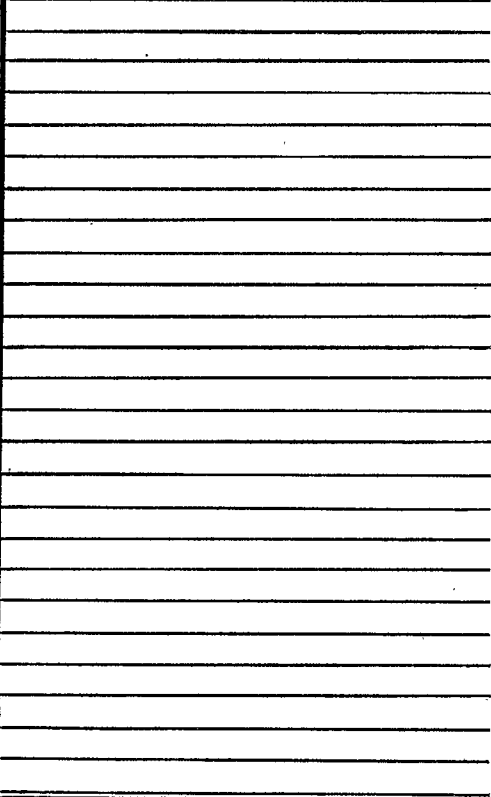

If more than one screen, show locations of each on sketch.