

Monroe Co  
K 30  
11-69

MISSISSIPPI  
BOARD OF WATER COMMISSIONERS  
416 North State Street  
Jackson, Mississippi 39201

CODED

WATER WELL DRILLERS LOG

11-27-69 19 Thurston - Lomax Well # Monroe  
date well completed firm name county well located

LANDOWNER: L. C. Cook  
Aberdeen, Miss  
(Contractor)  
(mailing address)

description of formations encountered	from	to
<u>Surface sand</u>	<u>0</u>	<u>18</u>
<u>Blue clay</u>	<u>18</u>	<u>220</u>
<u>Sand</u>	<u>220</u>	<u>360</u>
<u>Bottom</u>	<u>360</u>	

WELL LOCATION:  
sec. 18 T. 14 N. R. 6 E.  
2 miles N of Gibson  
(distance) (direction) (nearest town)

WELL PURPOSE: Home  
(home, irrigation, municipal, industrial)

- WELL COMPLETION DATA:
- (1) diameter (inches) 5"
  - (2) total depth (feet) 360
  - (3) static water level (feet) 130 below above top of ground.
  - (4) casing Steel 22'  
(material) (depth)  
5" if telescope see back.  
(size)
  - (5) screen no  
(length) (depth to top)  
(size) (material)
  - (6) pump 1/2 5  
(HP) (yield gpm)  
Electric  
(type power)
  - (7) electric log no  
(yes or no)  
(organization running log)
  - (8) how well bottom plugged open


DRILLERS REMARKS:

DEC 11 1969

MISS. BD. OF  
WATER COMMISSIONERS

If well telescopes please sketch and show depths.

GROUND LEVEL

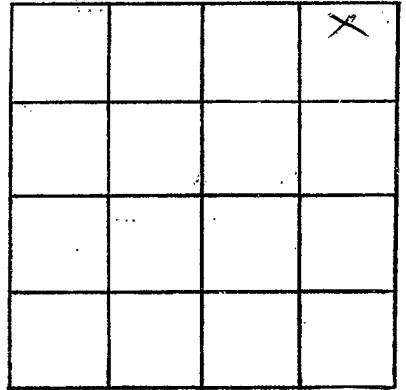

SECTION 18

Please indicate well location X.

ADDITIONAL INFORMATION

If more than one screen,  
show locations of each on sketch.