

Monroe  
K 31  
4-13-70

MISSISSIPPI  
BOARD OF WATER COMMISSIONERS  
416 North State Street  
Jackson, Mississippi 39201

COPIED

WATER WELL DRILLERS LOG

Herdon-Homan Well & Supply, Inc.

4-13 1970  
date well completed

firm name Box 42  
SHANNON, MISSISSIPPI 39360  
county well located Monroe

LANDOWNER: L.C. Cook  
(Contractor)  
Aberdeen  
(mailing address)

WELL LOCATION:  
sec. 2 T. 14 R. 6 E. 021  
2 miles N of Sibson  
(distance) (direction) (nearest town)

description of formations encountered	from	to
<u>Surface clay</u>	<u>0</u>	<u>18</u>
<u>Blue clay</u>	<u>18</u>	<u>240</u>
<u>Sand</u>	<u>240</u>	<u>360</u>
<u>Bottom</u>	<u>360</u>	

WELL PURPOSE: Home  
(home, irrigation, municipal, industrial)

WELL COMPLETION DATA:

- (1) diameter (inches) 5"
- (2) total depth (feet) 360'
- (3) static water level (feet) 88' below above top of ground.
- (4) casing Steel, 2 1/2",  
(material) (depth)  
5" if telescope see back.  
(size)
- (5) screen no,  
(length) (depth to top)  
(size) (material)
- (6) pump 3/4, 5  
(HP) (yield gpm)  
Electric  
(type power)
- (7) electric log no  
(yes or no)  
(organization running log)
- (8) how well bottom plugged open


DRILLERS REMARKS:

MAY 14 1970

MISS. BD. OF  
WATER COMMISSIONERS

If well telescopes please sketch and show depths.

GROUND LEVEL

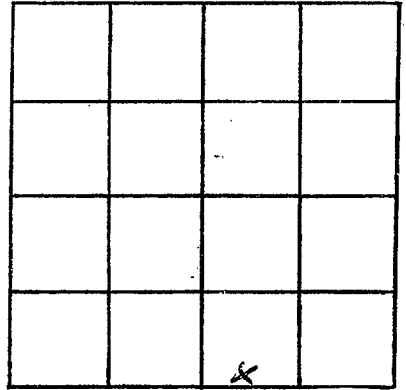

SECTION 8

Please indicate well location X.

ADDITIONAL INFORMATION

If more than one screen,  
show locations of each on sketch.