

MISSISSIPPI  
BOARD OF WATER COMMISSIONERS  
416 North State Street  
Jackson, Mississippi 39201

**CODED**

Monroe  
K32  
5-15-70

**WATER WELL DRILLERS LOG**  
Herndon-Homan Well & Supply, Inc.

5-15 19 70 P. O. Box 42 Monroe  
date well completed **SHANNON, MISSISSIPPI 38868** county well located

LANDOWNER: Shirley Adams  
(Contractor)  
Route 2, Amory, Miss  
(mailing address)

description of formations encountered	from	to
<u>Surface sand &amp; clay</u>	<u>0</u>	<u>28</u>
<u>Red clay</u>	<u>28</u>	<u>220</u>
<u>Sand</u>	<u>220</u>	<u>360</u>
<u>Blk.</u>	<u>360</u>	

WELL LOCATION:  
sec. 4 T. 14 N. R. 6 E.  
2 1/2 miles E of Esqot  
(distance) (direction) (nearest town)

WELL PURPOSE: home  
(home, irrigation, municipal, industrial)

- WELL COMPLETION DATA:
- (1) diameter (inches) 5"
  - (2) total depth (feet) 360'
  - (3) static water level (feet) 95 below above top of ground.
  - (4) casing Steel 30'  
(material) (depth)  
5" if telescope see back.  
(size)
  - (5) screen no  
(length) (depth to top)  
(size) (material)
  - (6) pump 1/3 5  
(HP) (yield gpm)  
Electric  
(type power)
  - (7) electric log no  
(yes or no)  
(organization running log)
  - (8) how well bottom plugged open

**CODED**


JUN 15 1970

DRILLERS REMARKS:

MISS. BD. OF  
WATER COMM.

If well telescopes please sketch and show depths.

GROUND LEVEL

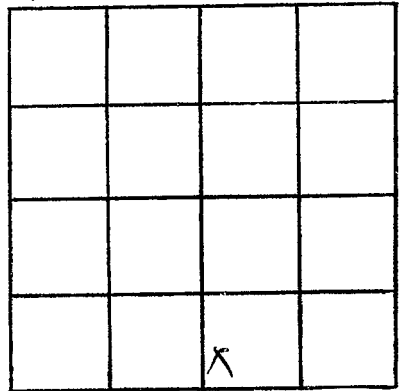

SECTION Y

Please indicate well location X.

ADDITIONAL INFORMATION

If more than one screen, show locations of each on sketch.