

MONROE
K 33
9-25-70

MISSISSIPPI
 BOARD OF WATER COMMISSIONERS
 416 North State Street
 Jackson, Mississippi 39201

CODED

WATER WELL DRILLERS LOG

9-25 1970 Walter Blanchard Home Monroe
 date well completed firm name county well located

LANDOWNER: Walter Blanchard
Route 3, Box 215
Aberdeen, Miss. 39130
 (mailing address)

description of formations encountered	from	to
<u>uniform clay</u>	<u>0</u>	<u>25</u>
<u>Blue clay</u>	<u>25</u>	<u>8</u>
<u>Sand</u>	<u>180</u>	<u>320</u>
<u>Bottom</u>	<u>320</u>	

WELL LOCATION:
 sec. 29 T. 54 N. R. 6 E.
2 3/4 miles W of Aberdeen
 (distance) (direction) (nearest town)

WELL PURPOSE: home
 (home, irrigation, municipal, industrial)

- WELL COMPLETION DATA:
- (1) diameter (inches) 5"
 - (2) total depth (feet) 320'
 - (3) static water level (feet) 72 below above top of ground.
 - (4) casing Steel 30
 (material) (depth)
5" if telescope see back.
 (size)
 - (5) screen no
 (length) (depth to top)
 (size) (material)
 - (6) pump 3/4 3
 (HP) (yield gpm)
Electric
 (type power)
 - (7) electric log no
 (yes or no)
 (organization running log)
 - (8) how well bottom plugged open

CODED


DRILLERS REMARKS:

OCT 12 1970

MISS. Bd. OF
 WATER COMM.

If well telescopes please sketch and show depths.

GROUND LEVEL

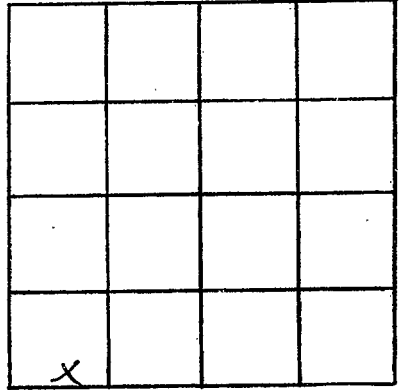

SECTION 2F

Please indicate well location X.

ADDITIONAL INFORMATION

If more than one screen, show locations of each on sketch.