

MONROE
K34
11-3-70

MISSISSIPPI
BOARD OF WATER COMMISSIONERS
416 North State Street
Jackson, Mississippi 39201

WATER WELL DRILLERS LOG

CODED

11-3 1970 Herndon-Horran Well Monroe
date well completed firm name & Supply county well located

LANDOWNER: H. Schreck

Route 3, Box 152

Aberdeen, Miss.
(mailing address)

description of formations encountered

from to

Surface sand	0	18
& clay	18	180
Shaly clay	180	300
Sand	300	
Gravel	300	

WELL LOCATION:

sec. 13 T. 14 N. R. 6 E
3 miles NW of Aberdeen
(distance) (direction) (nearest town)

WELL PURPOSE: home
(home, irrigation, municipal, industrial)

WELL COMPLETION DATA:

- (1) diameter (inches) 4"
- (2) total depth (feet) 300'
- (3) static water level (feet) 70 below above ground.
- (4) casing Steel, 25'
(material) (depth)
4"
(size) if telescope see back.
- (5) screen ND,
(length) (depth to top)
(size) (material)
- (6) pump ND,
(HP) (yield gpm)
(type power)
- (7) electric log ND
(yes or no)
(organization running log)
- (8) how well bottom plugged open

CODED


NOV 13 1970

DRILLERS REMARKS:

MISS. Bd. of
WATER COMM.

If well telescopes please sketch and show depths.

GROUND LEVEL

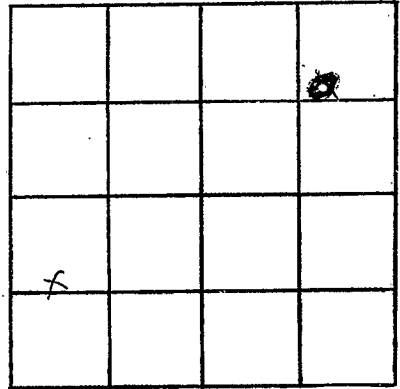

SECTION 03 12

Please indicate well location X.

ADDITIONAL INFORMATION

If more than one screen, show locations of each on sketch.