

MONROE  
K 36  
3-1-71

MISSISSIPPI  
BOARD OF WATER COMMISSIONERS  
416 North State Street  
Jackson, Mississippi 39201

WATER WELL DRILLERS LOG

**CODED**

Herndon-Homan Well & Supply, Inc.

Monroe

3-1 1971  
date well completed

SHANNON, MISSISSIPPI 38868

county well located

LANDOWNER: Jacob Lee  
Route 2  
Aberdeen, Miss. 39730  
(mailing address)

description of formations encountered	from	to
Surface sand & clay	0	18
Blue clay	18	180
Sand	180	200
Bottom	300	

WELL LOCATION:  
sec. 12 T. 14 N. R. 6 E.  
S. 3 miles NW of Aberdeen  
(distance) (direction) (nearest town)

WELL PURPOSE: home  
(home, irrigation, municipal, industrial)

- WELL COMPLETION DATA:
- (1) diameter (inches) 5"
  - (2) total depth (feet) 300
  - (3) static water level (feet) 90 below above top of ground.
  - (4) casing Steel, 20'5"  
(material) (depth)  
5" If telescope see back.  
(size)
  - (5) screen \_\_\_\_\_  
(length) (depth to top)  
(size) (material)
  - (6) pump \_\_\_\_\_  
(HP) (yield gpm)  
(type power)
  - (7) electric log no  
(yes or no)  
(organization running log)
  - (8) how well bottom plugged: open

**CODED**


APR 12 1971

DRILLERS REMARKS:

MISS. BD. OF  
WATER COMM.

If well telescopes please sketch and show depths.

GROUND LEVEL

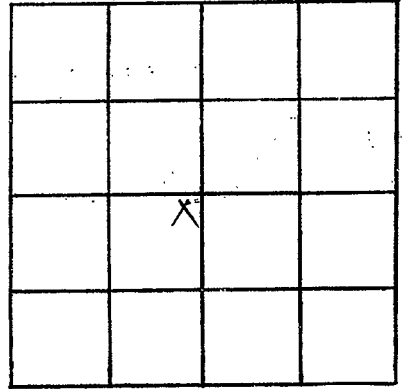

SECTION 12

Please indicate well location X.

ADDITIONAL INFORMATION

If more than one screen,  
show locations of each on sketch.