

MONROE
K 37
5-19-71

MISSISSIPPI
BOARD OF WATER COMMISSIONERS
416 North State Street
Jackson, Mississippi 39201

CODED

WATER WELL DRILLERS LOG

Bertram-Homan Well & Supply, Inc.

P. O. Box 42

Monroe

date well completed

19 71

Roosevelt DOCKINS

firm name MISSISSIPPI 10000 county well located

LANDOWNER:

Robert Clayton

Route 2, Aberdeen, Miss

(Contractor)

(mailing address)

description of formations encountered

from to

Sandy clay
Blue clay
Sand
Bottom

0 25
25 160
160 300
300

WELL LOCATION:

sec. 14 T 14 N R 6 E S W

2.5 miles NE of Gibson
(distance) (direction) (nearest town)

WELL PURPOSE:

Home

(home, irrigation, municipal, industrial)

WELL COMPLETION DATA:

- (1) diameter (inches) 5"
- (2) total depth (feet) 300
- (3) static water level (feet) 118 below above top of ground.
- (4) casing Steel 34'2"
(material) (depth)
- 5"
(size) If telescope see back.
- (5) screen no
(length) (depth to top)
- (size) (material)
- (6) pump 1/2 5
(HP) (yield gpm)
- electric
(type power)
- (7) electric log no
(yes or no)
- (organization running log)
- (8) how well bottom plugged open

CODED


MAY 15 1971

DRILLERS REMARKS:

MISS. DP. 95
WATER COMM.

If well telescopes please sketch and show depths.

GROUND LEVEL

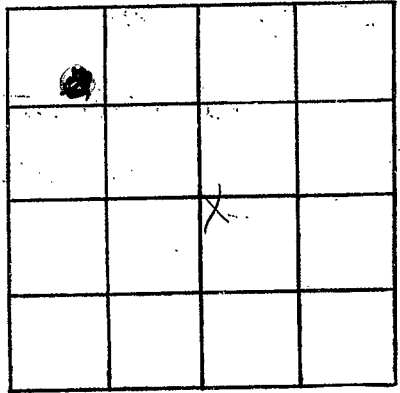

SECTION 14

Please indicate well location X.

ADDITIONAL INFORMATION

If more than one screen, show locations of each on sketch.