

MONROE
K 38
5-25-71

MISSISSIPPI
BOARD OF WATER COMMISSIONERS
416 North State Street
Jackson, Mississippi 39201

CODED

WATER WELL DRILLERS LOG

Hendon-Homan Well & Supply, Inc. *Morse*
P. O. Box 42

5-25 1971 date well completed
SHANNON, MISSISSIPPI 38609 county well located

LANDOWNER: *Jacob Lee, Jr.*
Route 2
Aberdeen Miss 39730
(mailing address)

description of formations encountered	from	to
<i>surface sand</i>	<i>0</i>	<i>33</i>
<i>clay</i>	<i>33</i>	<i>180</i>
<i>clay</i>	<i>180</i>	<i>320</i>
<i>Sand</i>		
<i>Bitum</i>	<i>320</i>	

WELL LOCATION:
sec. *11* T. *14* N. R. *6* E. S. *5*
3 1/2 miles *NW* of *Aberdeen*
(distance) (direction) (nearest town)

WELL PURPOSE: *home*
(home, irrigation, municipal, industrial)

- WELL COMPLETION DATA:
- (1) diameter (inches) *5"*
 - (2) total depth (feet) *320'*
 - (3) static water level (feet) *80* below top of ground.
 - (4) casing *Steel* *37'7"*
(material) (depth)
5" if telescope see back.
(size)
 - (5) screen *NO*, (depth to top)
(length) (depth to top)
(size) (material)
 - (6) pump *NO* (HP) (yield gpm)
(type power)
 - (7) electric log *NO* (yes or no)
(organization running log)
 - (8) how well bottom plugged *open*

CODED


DRILLERS REMARKS:

MAY 25 1971

MISS. CO. OF
WATER COMM.

If well telescopes please sketch and show depths.

GROUND LEVEL

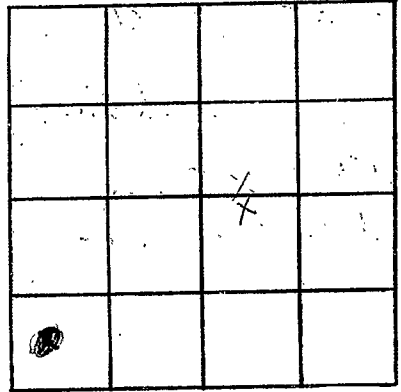

SECTION *12*

Please indicate well location X.

ADDITIONAL INFORMATION

If more than one screen, show locations of each on sketch.