

MONROE
K 39
6-21-71

MISSISSIPPI
BOARD OF WATER COMMISSIONERS
416 North State Street
Jackson, Mississippi 39201

CODED

WATER WELL DRILLERS LOG

Herndon-Homan Well & Supply, Inc. *Monroe*
P. O. Box 42
BIANNON, MISSISSIPPI 39308 county well located

6-21 1971
date well completed
WARDELL SHAW

LANDOWNER: *Cooperative Home Builders (Contractors)*
Aberdeen, Miss.
(mailing address)

description of formations encountered	from	to
surface sand	0	28
E. CLAY	28	180
Blue clay	180	320
Sand		
Bottom	320	

WELL LOCATION:
sec. 14 T. 14 N. R. 6 E
S
1/2 miles NW of Aberdeen
(distance) (direction) (nearest town)

WELL PURPOSE: *home*
(home, irrigation, municipal, industrial)

- WELL COMPLETION DATA:
- diameter (inches) 5"
 - total depth (feet) 320'
 - static water level (feet) 98 below top of ground.
 - casing Steel 34'
(material) (depth)
5" if telescope see back.
(size)
 - screen 20 (length) (depth to top)
(size) 1/2 (material)
(HP) 5 (yield gpm)
 - electric log no
(yes or no)
(organization running log)
 - how well bottom plugged open

CODED


III 12 1971

MISS. RD. OR
WATER COMM.

DRILLERS REMARKS:

If well telescopes please sketch and show depths.

GROUND LEVEL

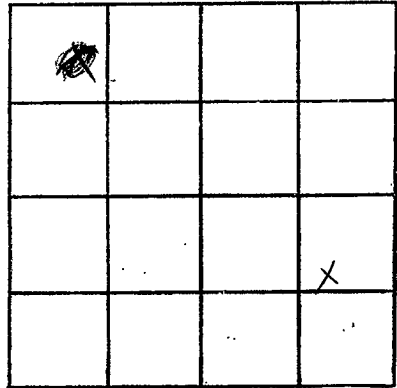

SECTION 14

Please indicate well location X.

ADDITIONAL INFORMATION

If more than one screen,
show locations of each on sketch.