

MONROE
K-40
7-20-71

MISSISSIPPI
BOARD OF WATER COMMISSIONERS
416 North State Street
Jackson, Mississippi 39201

CODED

WATER WELL DRILLERS LOG

~~Marion-Homan~~ Well & Supply, Inc.

P. O. Box 42

Monroe

7-20 1971
date well completed

MISSISSIPPI 39201 county well located

LANDOWNER: Ley Williams
Route 3
Aberdeen, Miss 39130
(mailing address)

description of formations encountered	from	to
<u>Surface sand & clay</u>	<u>0</u>	<u>18</u>
<u>Blue clay</u>	<u>18</u>	<u>180</u>
<u>Sand</u>	<u>180</u>	<u>320</u>
<u>Bottom</u>	<u>320</u>	

WELL LOCATION:
sec. 15 T. 14 N. R. 6 E.
S. W.
2 miles NE of Gibson
(distance) (direction) (nearest town)

WELL PURPOSE: home
(home, irrigation, municipal, industrial)

- WELL COMPLETION DATA:
- (1) diameter (inches) 5"
 - (2) total depth (feet) 320'
 - (3) static water level (feet) 100 below above top of ground.
 - (4) casing Steel, 22 (material) (depth)
5" if telescope see back. (size)
 - (5) screen no (length) (depth to top)
(size) (material)
 - (6) pump 1/2 5 (HP) (yield gpm)
electric (type power)
 - (7) electric log no (yes or no)
(organization running log)
 - (8) how well bottom plugged open

CODED


AUG 4 - 1971

MISS. BD. OF
WATER COM.

DRILLERS REMARKS:

If well telescopes please sketch and show depths.

GROUND LEVEL

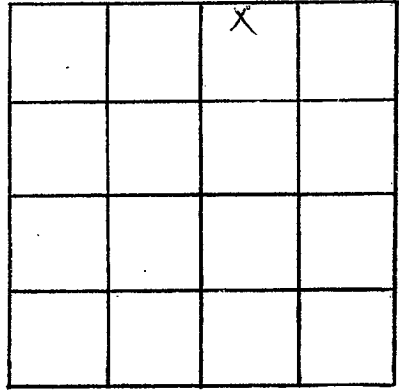

SECTION 15

Please indicate well location X.

ADDITIONAL INFORMATION

If more than one screen, show locations of each on sketch.