

MONROE
K 42
11-26-71

MISSISSIPPI
BOARD OF WATER COMMISSIONERS
416 North State Street
Jackson, Mississippi 39201

CODED 971

WATER WELL DRILLERS LOG

Herndon-Homan Well & Supply, Inc.

P. O. Box 42

Monroe

Apr 26 1971
date well completed


BIANNON MISSISSIPPI 38868 county well located

LANDOWNER:	description of formations encountered	from to
Charles Gardner	Sand and clay	0 93
P.O. Aberdeen, Miss. (mailing address)	Blue clay Sand Btm	33 62 60 62 320
WELL LOCATION: sec. 4 T. 14 N. R. 6 E S W 2 1/2 miles SE of Egypt (distance) (direction) (nearest town)		
WELL PURPOSE: Home (home, irrigation, municipal, industrial)		
WELL COMPLETION DATA: (1) diameter (inches) 5 (2) total depth (feet) 300 (3) static water level (feet) 78 below above top of ground. (4) casing (material) steel, (depth) 36' 6" 5 (size) if telescope see back. (5) screen (length) ND, (depth to top) ND (size) (material) (6) pump 1/2 (HP) 5 (yield gpm) electric (type power) (7) electric log ND (yes or no) (organization running log) (8) how well bottom plugged open		
DRILLERS REMARKS:		

CODED

If well telescopes please sketch and show depths:

GROUND LEVEL

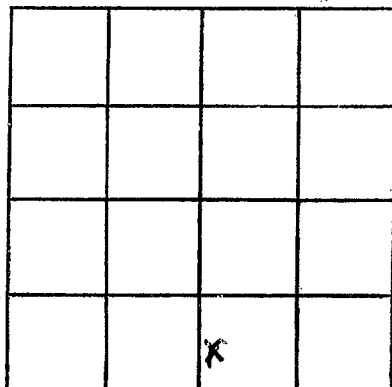

SECTION f

Please indicate well location X.

ADDITIONAL INFORMATION

If more than one screen, show locations of each on sketch.