

MONROE
K 43
12-1-71

MISSISSIPPI
BOARD OF WATER COMMISSIONERS
416 North State Street
Jackson, Mississippi 39201

CODED

WATER WELL DRILLERS LOG

Merndon-Homan Well & Supply, Inc.

P. O. Box 42

BIANCON, MISSISSIPPI 38809

Monroe

12-1-1971 date well completed

county well located

LANDOWNER:
Charles Gardner
43, Aberdeen, Miss.
(mailing address)

description of formations encountered

from to

Surface clay	0	28
Blue clay	28	160
Sand	160	300
Bottom	300	

WELL LOCATION:

sec. 4 T 14 N R 6 E
S W
2 1/2 miles E of Egypt
(distance) (direction) (nearest town)

WELL PURPOSE:

(home, irrigation, municipal, industrial) Home

WELL COMPLETION DATA:

- (1) diameter (inches) 5
- (2) total depth (feet) 300
- (3) static water level (feet) 98 below above top of ground.
- (4) casing steel, 36' 6" (material) (depth)
- 5 (size) if telescope see back.
- (5) screen NO (length) (depth to top)
- (size) (material)
- (6) pump 1/2 (HP) 5 (yield gpm)
- electric (type power)
- (7) electric log NO (yes or no)
- (organization running log)
- (8) how well bottom plugged open

CODED

JAN 14 1972
JAN 14 1972


MISS. BD. OF

WATER

DRILLERS REMARKS:

If well telescopes please sketch and show depths.

GROUND LEVEL

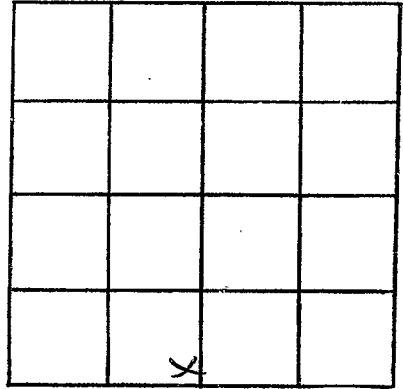

SECTION 4

Please indicate well location X.

ADDITIONAL INFORMATION

If more than one screen, show locations of each on sketch.