

MONROE
K44
01-68

MISSISSIPPI
BOARD OF WATER COMMISSIONERS
416 North State Street
Jackson, Mississippi 39201

CODED

WATER WELL DRILLERS LOG

date well completed 1/12/68 Herndon-Homan Well & Supply, Monroe
firm name Box 22 county well located SHANNON, MISSISSIPPI 38868

LANDOWNER: LUCINDA POE
~~Lucinda Poe~~ (mailing address)
Equip. miss


description of formations encountered	from	to
surface sand & clay	0	30
Blue clay	30	200
Sand	200	320
Gravel	320	

WELL LOCATION:
sec. 15 T. 14 N. R. 6 E.
S. W.
miles SE of Egypt
(distance) (direction) (nearest town)

WELL PURPOSE: Home
(home, irrigation, municipal, industrial)

- WELL COMPLETION DATA:
- (1) diameter (inches) 4"
 - (2) total depth (feet) 320'
 - (3) static water level (feet) 85' below top of ground.
 - (4) casing Steel, 34' (material) (depth)
(size) if telescope see back.
 - (5) screen None (length) (depth to top)
(size) (material)
 - (6) pump None (HP) (yield gpm)
(type power)
 - (7) electric log No (yes or no)
(organization running log)
 - (8) how well bottom plugged open

CODED

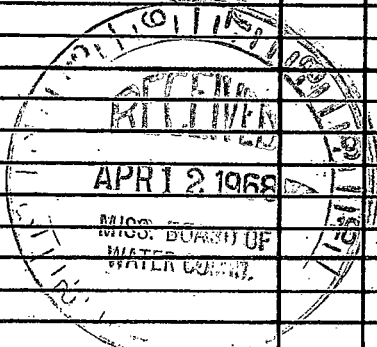

DRILLERS REMARKS:

If well telescopes please sketch and show depths.

GROUND LEVEL

			⊗
			X

SECTION 15

Please indicate well location X.

ADDITIONAL INFORMATION

If more than one screen,
show locations of each on sketch.