

Monroe
K 45
6-68

MISSISSIPPI
 BOARD OF WATER COMMISSIONERS
 416 North State Street
 Jackson, Mississippi 39201

CODED

WATER WELL DRILLERS LOG

6-25 1968 Herndon-Homan Well & Supply, Inc. Monroe
 date well completed firm name Box 42 county well located
SHANNON, MISSISSIPPI 38868

LANDOWNER: EARK WHITLEY
Eark Whitley
203 Aberdeen, Miss
 (mailing address)

description of formations encountered	from	to
<u>surface sand</u>		
<u>clay</u>	<u>0</u>	<u>33</u>
<u>Bluish clay</u>	<u>33</u>	<u>180</u>
<u>Sand</u>	<u>180</u>	<u>300</u>
<u>bottom</u>	<u>300</u>	

WELL LOCATION:
 sec. 14 T. 14 N R. 6 E
S 5 miles SW of Aberdeen
 (distance) (direction) (nearest town)

WELL PURPOSE: Home
 (home, irrigation, municipal, industrial)

- WELL COMPLETION DATA:
- (1) diameter (inches) 5
 - (2) total depth (feet) 300
 - (3) static water level (feet) 101 below above top of ground.
 - (4) casing Steel, 36" 4"
 (material) (depth)
5 if telescope see back.
 (size)
 - (5) screen 20,
 (length) (depth to top)
 (size) (material)
 - (6) pump 1/3 5
 (HP) (yield gpm)
electric
 (type power)
 - (7) electric log NO
 (yes or no)
 (organization running log)
 - (8) how well bottom plugged good


CODED

MISSISSIPPI
 BOARD OF WATER COMMISSIONERS
 JACKSON, MISSISSIPPI

DRILLERS REMARKS:

If well telescopes please sketch and show depths.

GROUND LEVEL

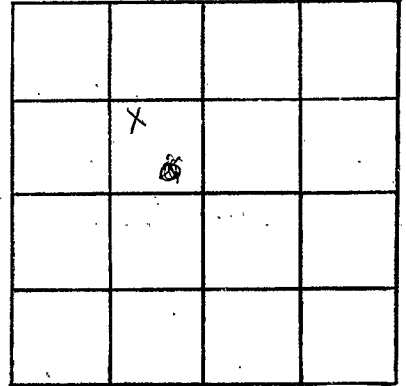

SECTION 14

Please indicate well location X.

ADDITIONAL INFORMATION

If more than one screen, show locations of each on sketch.