

MONROE

K 47

3-68

MISSISSIPPI
 BOARD OF WATER COMMISSIONERS
 416 North State Street
 Jackson, Mississippi 39201

CODED

WATER WELL DRILLERS LOG

3-25-68 Herndon-Homan Well & Supply, MONROE
 date well completed firm name Box #2 county well located
 SHANNON, MISSISSIPPI 38868

LANDOWNER:
John Phaedler
At 3 Box 157, Aberdeen, Miss
 (mailing address)


description of formations encountered	from	to
<u>surface clay</u>	<u>0</u>	<u>28</u>
<u>blue sand</u>	<u>28</u>	<u>180</u>
<u>gravel</u>	<u>181</u>	<u>300</u>
<u>bottom</u>	<u>300</u>	

WELL LOCATION:
13 sec. 9 T. 14 N. R. 6 E.
5 miles NW of Aberdeen
 (distance) (direction) (nearest town)

WELL PURPOSE: Home
 (home, irrigation, municipal, industrial)

- WELL COMPLETION DATA:
- (1) diameter (inches) 4
 - (2) total depth (feet) 300
 - (3) static water level (feet) 100 below above top of ground.
 - (4) casing steel, 30,
 (material) (depth)
no if telescope see back.
 (size)
 - (5) screen NONE
 (length) (depth to top)
 (size) (material)
 - (6) pump 3/4 3
 (HP) (yield gpm)
electric
 (type power)
 - (7) electric log no
 (yes or no)
 (organization running log)
 - (8) how well bottom plugged open


CODED

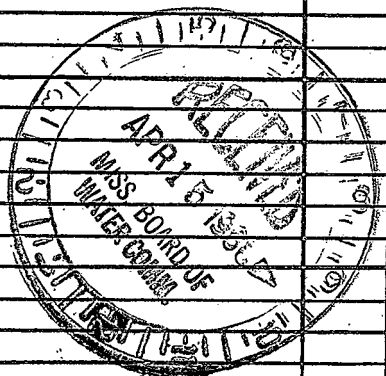

DRILLERS REMARKS:

If well telescopes please sketch and show depths.

GROUND LEVEL

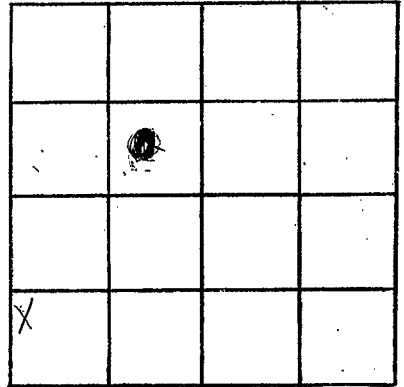

SECTION ¹³ ~~12~~

Please indicate well location X.

ADDITIONAL INFORMATION

If more than one screen, show locations of each on sketch.