

Monroe
K 48
8-66

MISSISSIPPI BOARD OF WATER COMMISSIONERS

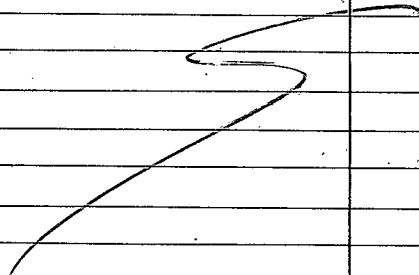
CODED

WATER WELL DRILLERS LOG

Herndon-Homan Well & Supply, Inc.

Date: Aug 22, 1966, Driller: P. O. Box 42 County Monroe
(When well drilled) SEANNON, MISSISSIPPI 38862 (Where well is located)

(1) Owner of Land: Milton Lee
(Name)
At 3 Aberdeen Miss
NW SE SW (Address)
(2) Location: 1/4, NE 1/4, Sec 12 T. 43S R. 6E
5 miles NW of Aberdeen
(distance) (direction) (Nearest Town)
(3) Topography: Flat
(Hilly) (Flat) (Level)
(4) Purpose of Well: Domestic
(Domestic Irrigation
Municipal, Industrial, Other)

Description & Color of Materials Sand, Clay, Red Clay, Shell, etc.	Thick- ness Feet	Depth Feet
<u>surface sand</u>		
<u>5 layers</u>		<u>0-20</u>
<u>Blue clay</u>		<u>20-195</u>
<u>sand</u>		<u>195-320</u>
<u>Bottom</u>		<u>320</u>
		
CODED		

Information upon completion of well:

(1) Diameter: 5 inches.
(2) Total Depth: 320 feet.
(3) Water Level: 55 feet below top of ground.
(4) Cased to: 22' 10", Size: 54
(5) Screen: Size none, Length —
(6) Were any formations sealed against pollution?
yes, no.

If YES depth of formation 20'
Why surface & sand
Drillers Remarks:
Yield in gpm: 4 RPM
Size pump: 3/4 HP Int
Type power: Electric

