

Monroe
K 49
3-67

MISSISSIPPI
BOARD OF WATER COMMISSIONERS
416 North State Street
Jackson, Mississippi 39201

CODED

WATER WELL DRILLERS LOG
Herndon-Homan Well & Supply, Inc.

3-7 1967 P. O. Box 42
date well completed SHANNON, MISSISSIPPI 38868 Monroe
county well located

LANDOWNER:
Norman Lee
Pt 3, Aberdeen, Miss
(mailing address)


description of formations encountered	from	to
Surface sand		
Clay	0	17
Blond clay	17	19.5
Sand	19.5	280
Rock	280	281
Sand	281	320
Bottom	320	

WELL LOCATION:
12 sec 14 T 14 N R 6 E S
5 miles NW of Aberdeen
(distance) (direction) (nearest town)

WELL PURPOSE: Home
(home, irrigation, municipal, industrial)

- WELL COMPLETION DATA:
- (1) diameter (inches) 4"
 - (2) total depth (feet) 320'
 - (3) static water level (feet) 55' below top of ground.
 - (4) casing Steel, 20 1/2" (material), (depth)
4" If telescope see back.
(size)
 - (5) screen 1/2" x 1/2" (length) (depth to top)
(size) (material)
 - (6) pump 3/4 HP 4 (yield gpm)
Electric (type power)
 - (7) electric log NO (yes or no)
(organization running log)
 - (8) how well bottom plugged open


CODED

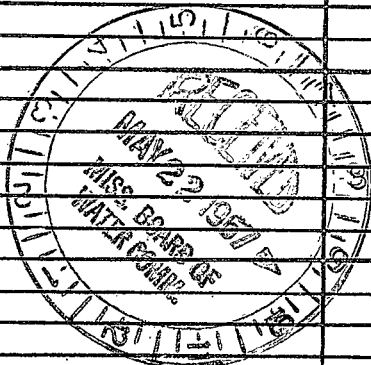

DRILLERS REMARKS:

If well telescopes please sketch and show depths.

GROUND LEVEL

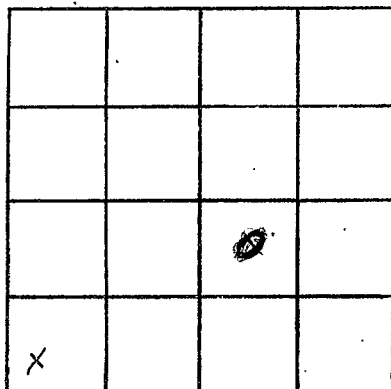

SECTION 12

Please indicate well location X.

ADDITIONAL INFORMATION

If more than one screen, show locations of each on sketch.