

Monroe
K 51
7-68

MISSISSIPPI
BOARD OF WATER COMMISSIONERS
416 North State Street
Jackson, Mississippi 39201

CODED

WATER WELL DRILLERS LOG

Horndon-Homan Well & Supply, Inc. *Monroe*

date well completed *7/31 1968* firm name *Box 42* county well located *Monroe*

TRAILER *STANTON* *MISSISSIPPI 39066*

LANDOWNER:	description of formations encountered	from	to
<i>SCHROCK</i>	<i>Surface Sand</i>		
<i>I. S. Schrock</i>	<i>S. Clay</i>	<i>0</i>	<i>25</i>
<i>At 3 Aberdeen Miss</i> (mailing address)	<i>Blue Clay</i>	<i>25</i>	<i>200</i>
	<i>Sand</i>	<i>200</i>	<i>310</i>
	<i>Bottom</i>	<i>320</i>	


WELL LOCATION:
12 sec. *14* T. *14* N. R. *6* E.
3 1/2 miles *SW* of *Aberdeen*
(distance) (direction) (nearest town)

WELL PURPOSE: *Home*
(home, irrigation, municipal, industrial)

WELL COMPLETION DATA:

- (1) diameter (inches) *5 1/2"*
- (2) total depth (feet) *320'*
- (3) static water level (feet) *80'* below top of ground
- (4) casing *steel* *33 1/2"*
(material) (depth)
- 5 1/2"* if telescope see back.
(size)
- (5) screen *60'* (length) (depth to top)
- (size) (material)
- (6) pump *2 1/2 HP* *2 1/2 gpm*
(HP) (yield gpm)
- (type power)
- (7) electric log *NO* (yes or no)
- (organization running log)
- (8) how well bottom plugged *open*


CODED

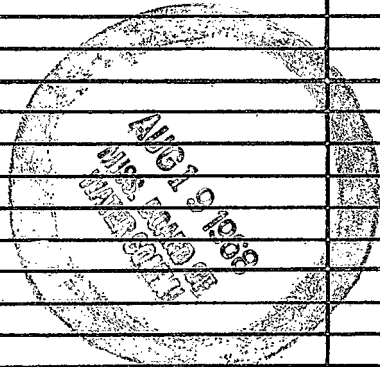

DRILLERS REMARKS:

If well telescopes please sketch and show depths.

GROUND LEVEL

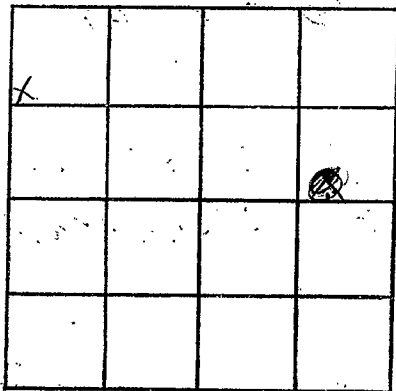

SECTION 12

Please indicate well location X.

ADDITIONAL INFORMATION

If more than one screen, show locations of each on sketch.