

MONROE
K 52
5-5-72

MISSISSIPPI
 BOARD OF WATER COMMISSIONERS
 416 North State Street
 Jackson, Mississippi 39201

CODED

WATER WELL DRILLERS LOG

date well completed 5-5-72 19 72 Herndon-Homan Well & Supply, Inc. Monroe
 firm name SHANNON, MISSISSIPPI 38868 Box 42 county well located

LANDOWNER: Robert C. Johnson
Will, Joe Johnson
AJ, Aberdeen, Miss
 (mailing address)

description of formations encountered	from	to
<u>Surface sand & clay</u>	<u>0</u>	<u>30</u>
<u>Blue clay</u>	<u>30</u>	<u>160</u>
<u>Sand</u>	<u>160</u>	<u>300</u>
<u>Bottom</u>	<u>300</u>	

WELL LOCATION:
 sec 9 T 14 R 6 E
S miles NW of Aberdeen
 (distance) (direction) (nearest town)

WELL PURPOSE: Home
 (home, irrigation, municipal, industrial)

- WELL COMPLETION DATA:
- (1) diameter (inches) 5"
 - (2) total depth (feet) 300'
 - (3) static water level (feet) 93' below above top of ground.
 - (4) casing steel, 35" 6"
 (material) (depth)
8 if telescope see back.
 (size)
 - (5) screen ND,
 (length) (depth to top)
 (size) (material)
 - (6) pump 1/2, 5
 (HP) (yield gpm)
electric
 (type power)
 - (7) electric log no
 (yes or no)
 (organization running log)
 - (8) how well bottom plugged open

CODED


DAV 1 9 1972
 WPT 1 2 1972

DRILLERS REMARKS:

MISS. BD. OF
 WATER CONTROL

If well telescopes please sketch and show depths.

GROUND LEVEL

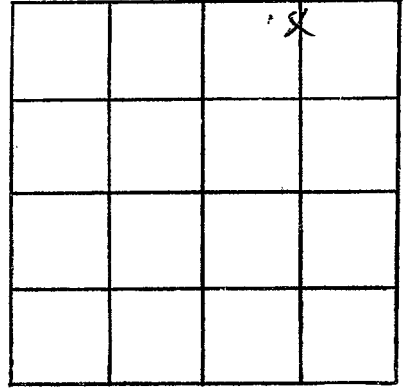

SECTION 9

Please indicate well location X.

ADDITIONAL INFORMATION

If more than one screen,
show locations of each on sketch.