

MONROE  
K53  
6-21-72

MISSISSIPPI  
BOARD OF WATER COMMISSIONERS  
416 North State Street  
Jackson, Mississippi 39201

WATER WELL DRILLERS LOG

**CODED**

6/21 1972 Herman Homan Well & Supply, Inc.  
date well completed P.O. Box 42

Monroe  
county well located

LANDOWNER: Robert Claster  
McClaster

SHANNON, MISSISSIPPI 38868

description of formations encountered	from	to
Surface sand & clay	0	28
Blue clay	28	160
Sand	160	300
Bottom	300	

Dr J. Aberdeen Min  
(mailing address)

WELL LOCATION:  
sec. 3 T 14 N R 6 E S W  
5 miles NW of Aberdeen  
(distance) (direction) (nearest town)

WELL PURPOSE: Home  
(home, irrigation, municipal, industrial)

- WELL COMPLETION DATA:
- (1) diameter (inches) 5.00
  - (2) total depth (feet) 300'
  - (3) static water level (feet) 97' below top of ground.
  - (4) casing steel, 70' 4" (material) (depth)  
5 (size) if telescope see back.
  - (5) screen 1/2" (length) (depth to top)  
(size) (material)
  - (6) pump 1/2 HP, 5 (yield gpm)  
electric (type power)
  - (7) electric log no (yes or no)  
(organization running log)
  - (8) how well bottom plugged good


**CODED**

DRILLERS REMARKS:

JUL 13 1972

If well telescopes please sketch and show depths.

GROUND LEVEL

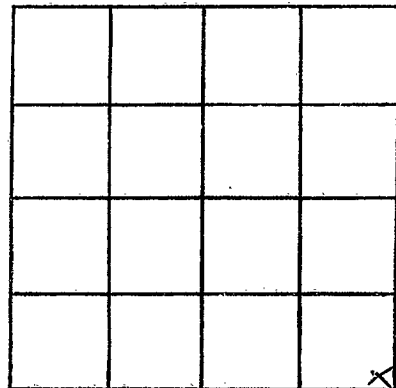

SECTION 3

Please indicate well location X.

ADDITIONAL INFORMATION

If more than one screen,  
show locations of each on sketch.