

MONROE
K 54
6-21-72

MISSISSIPPI
BOARD OF WATER COMMISSIONERS
416 North State Street
Jackson, Mississippi 39201

CODED

WATER WELL DRILLERS LOG

Herman Homan Well & Supply, Inc.

Monroe

6/21 1972
date/well completed

P. O. Box 42

SHANNON, MISSISSIPPI 38668

county well located

LANDOWNER: *L. C. Cook, (int)*

description of formations encountered

from to

Albert Wava
Aberdeen, M. 35
(mailing address)

<i>Surface sand</i>	<i>0</i>	<i>32</i>
<i>Clay</i>	<i>-</i>	<i>-</i>
<i>Shale clay</i>	<i>32</i>	<i>160</i>
<i>Sand</i>	<i>160</i>	<i>300</i>
<i>Bottom</i>	<i>300</i>	

WELL LOCATION:

sec. *12* T. *18* N. R. *6* E.
S. *5* W. *4*
3 miles *N.W.* of *Aberdeen*
(distance) (direction) (nearest town)

WELL PURPOSE: *Home*
(home, irrigation, municipal, industrial)

WELL COMPLETION DATA:

- (1) diameter (inches) *5*
- (2) total depth (feet) *300*
- (3) static water level (feet) *71* below above top of ground.
- (4) casing *Steel*, *36" x 6'*
(material) (depth)
5 if telescope see back.
(size)
- (5) screen *NO*,
(length) (depth to top)
(size) (material)
- (6) pump *1/2*, *5*
(HP) (yield gpm)
electric
(type power)
- (7) electric log *NO*
(yes or no)
(organization running log)
- (8) how well bottom plugged *Steel*

CODED


DRILLERS REMARKS:

APR 13 1972

MISSISSIPPI
BOARD OF WATER COMMISSIONERS
JACKSON, MISSISSIPPI

If well telescopes please sketch and show depths.

GROUND LEVEL

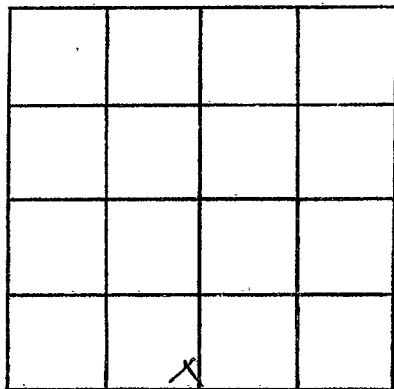

SECTION 12

Please indicate well location X.

ADDITIONAL INFORMATION

If more than one screen, show locations of each on sketch.