

MISSISSIPPI
BOARD OF WATER COMMISSIONERS
416 North State Street
Jackson, Mississippi 39201

CODED

WATER WELL DRILLERS LOG

MONROE
K57
9-11-72

9-11-72
date well completed

1972 Herman Homan Well & Supply, Inc.

P.O. Box 42
firm name

Monroe
county well located

SHANNON MISSISSIPPI 38668

LANDOWNER:

description of formations encountered

from to

Bill Gates
at 3 Box 506 Aberdeen
(mailing address) MS 39007

Surface clay	0	33
Other clay	33	180
Sand	180	320
Bottom	320	

WELL LOCATION:

sec. 22 T. 14 N. R. 6 E. S. 1 W. 1
2 1/2 miles N of Prairie
(distance) (direction) (nearest town)

WELL PURPOSE:

Home
(home, irrigation, municipal, industrial)

WELL COMPLETION DATA:

- diameter (inches) 5 1/4
- total depth (feet) 320
- static water level (feet) 88' below top of ground
- casing 5 feet (material) 35' (depth)
5 1/4" (size) if telescope see back.
- screen 108 (length) (depth to top)
(size) (material)
- pump 1 (HP) 5 (yield gpm)
electric (type power)
- electric log NO (yes or no)
(organization running log)
- how well bottom plugged Open

CODED


SEP 26 1972

DRILLERS REMARKS:

MISC. DR.
MISSISSIPPI BOARD OF WATER COMMISSIONERS

If well telescopes please sketch and show depths.

GROUND LEVEL

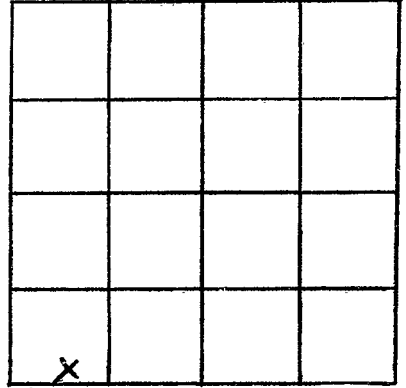

SECTION 22

Please indicate well location X.

ADDITIONAL INFORMATION

If more than one screen,
show locations of each on sketch.