

MONROE
K58
11-6-72

MISSISSIPPI
BOARD OF WATER COMMISSIONERS
416 North State Street
Jackson, Mississippi 39201
WATER WELL DRILLERS LOG

CODED

11-6 date well completed 1972 Herman Homan Well & Supply, Inc. P. O. Box 42 county well located Monroe

SHANNON, MISSISSIPPI 38608

LANDOWNER:
Daniel C. Cunningham
Rt 1, Oleokona Miss
(mailing address)

description of formations encountered	from	to
Surface sand	0	28
clay	28	180
Blue clay	180	300
sand		
Bottom	300	

WELL LOCATION:
sec. 9 T. 14^N R. 6^E
3 miles E of Egypt
(distance) (direction) (nearest town)

WELL PURPOSE: Home
(home, irrigation, municipal, industrial)


- WELL COMPLETION DATA:
- diameter (inches) 5"
 - total depth (feet) 300'
 - static water level (feet) 89' below top of ground.
 - casing Steel, 37' 9" (material) (depth)
5" (size) if telescope see back.
 - screen No (length) (depth to top)
(size) (material)
 - pump 1/2 (HP) 5 (yield gpm)
electric (type power)
 - electric log No (yes or no)
(organization running log)
 - how well bottom plugged Open

CODED

DRILLERS REMARKS:

If well telescopes please sketch and show depths.

GROUND LEVEL

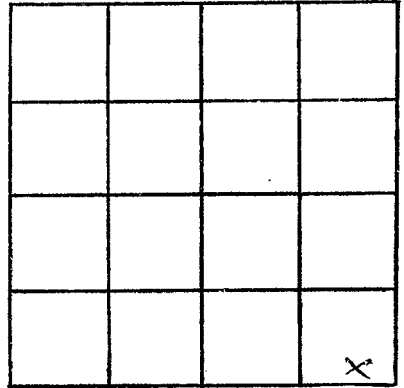

SECTION 9

Please indicate well location X.

ADDITIONAL INFORMATION

If more than one screen,
show locations of each on sketch.