

MONROE  
K 59  
12-19-72

MISSISSIPPI  
BOARD OF WATER COMMISSIONERS  
416 North State Street  
Jackson, Mississippi 39201  
WATER WELL DRILLERS LOG

**CODED**

12-19-1972 Herman Homan Well & Supply, Inc. Monroe  
date well completed firm name county well located

Contract No. 00  
LANDOWNER: David Holliday

description of formations encountered	from	to
<u>surface clay</u>	<u>0</u>	<u>30</u>
<u>Blue clay</u>	<u>30</u>	<u>180</u>
<u>sand</u>	<u>180</u>	<u>210</u>
<u>stard rock</u>	<u>210</u>	<u>219</u>
<u>sand</u>	<u>219</u>	<u>320</u>
<u>Bottom</u>	<u>320</u>	

Williams Job

273, Aberdeen, Miss  
(mailing address)

WELL LOCATION:  
sec. 9 T. 14 N. R. 6 E.  
S. W.  
3 miles NE of Gibson  
(distance) (direction) (nearest town)

WELL PURPOSE: Home  
(home, irrigation, municipal, industrial)


- WELL COMPLETION DATA:
- (1) diameter (inches) 5"
  - (2) total depth (feet) 320'
  - (3) static water level (feet) 76' below above top of ground.
  - (4) casing steel, 35',  
(material) (depth)  
5" if telescope see back.  
(size)
  - (5) screen ND,  
(length) (depth to top)  
(size) (material)
  - (6) pump 1/2, 5  
(HP) (yield gpm)  
electric  
(type power)
  - (7) electric log no  
(yes or no)  
(organization running log)
  - (8) how well bottom plugged open

DRILLERS REMARKS:

JAN 26 1973

If well telescopes please sketch and show depths.

GROUND LEVEL

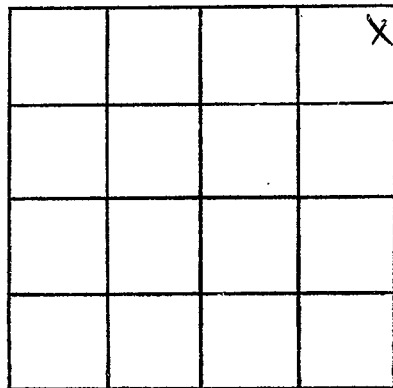

SECTION 9

Please indicate well location X.

ADDITIONAL INFORMATION

If more than one screen,  
show locations of each on sketch.