

**MISSISSIPPI
BOARD OF WATER COMMISSIONERS
416 North State Street
Jackson, Mississippi 39201**

CODED

WATER WELL DRILLERS LOG

Herman Homan Well & Supply, Inc.

P.O. Box 42
SHANNON, MISSISSIPPI 38668

MONROE
K 60
12-21-72

12-21-1972 date well completed P.O. Box 42 Monroe county well located

LANDOWNER: Robert Clayton
Nathan Hodges
RT 3, Aberdeen, Miss
(mailing address)

| description of formations encountered | from | to |
|---------------------------------------|------------|------------|
| <u>Surface clay</u> | <u>0</u> | <u>18</u> |
| <u>Blue clay</u> | <u>18</u> | <u>180</u> |
| <u>SAND</u> | <u>180</u> | <u>320</u> |
| <u>Benton</u> | <u>320</u> | |

WELL LOCATION:
sec. 7 T. 14 N. R. 6 E.
3 1/2 miles NE of Gibson
(distance) (direction) (nearest town)

WELL PURPOSE: Home
(home, irrigation, municipal, industrial)


- WELL COMPLETION DATA:
- diameter (inches) 5"
 - total depth (feet) 320'
 - static water level (feet) 85' below above top of ground.
 - casing Steel 20' 2"
(material) (depth)
5 if telescope see back.
(size)
 - screen 40 (length) (depth to top)
(size) (material)
 - pump 1/2 5
(HP) (yield gpm)
electric
(type power)
 - electric log no
(yes or no)
(organization running log)
 - how well bottom plugged open

DRILLERS REMARKS:

MISS. B. 12
WATER U. 12

If well telescopes please sketch and show depths.

GROUND LEVEL

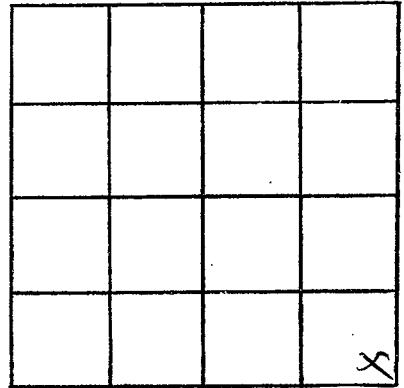

SECTION f

Please indicate well location X.

ADDITIONAL INFORMATION

If more than one screen,
show locations of each on sketch.