

MONROE
K 61
12-21-72

MISSISSIPPI
BOARD OF WATER COMMISSIONERS
416 North State Street
Jackson, Mississippi 39201

CODED

WATER WELL DRILLERS LOG

Herman Homan Well & Supply, Inc.

P. O. Box 42

SHANNON, MISSISSIPPI 38268

Monroe

12-21-72
date well completed

Monroe
county well located

LANDOWNER: Robert Clayton

description of formations encountered

from to

SAM RAY

surface clay

0 16

RT 3, Aberdeen, Miss.
(mailing address)

Blue clay

16 180

Sand

180 210

Hard Rock

210 214

Sand

214 320

Bottom

320

WELL LOCATION:

sec. 10 T. 14 N. R. 6 E. S. 1 W.
3 1/2 miles NE of Gibson
(distance) (direction) (nearest town)

WELL PURPOSE: Home
(home, irrigation, municipal, industrial)

WELL COMPLETION DATA:


- (1) diameter (inches) 5"
- (2) total depth (feet) 320'
- (3) static water level (feet) 84' below top of ground.
- (4) casing Steel, 38 1/2" (material) (depth)
- 5" (size) if telescope see back.
- (5) screen NO (length) (depth to top)
- (size) (material)
- (6) pump 1/2 (HP) 5 (yield gpm)
- electric (type power)
- (7) electric log NO (yes or no)
- (organization running log)
- (8) how well bottom plugged open

DRILLERS REMARKS:

20 12 1973

If well telescopes please sketch and show depths.

GROUND LEVEL

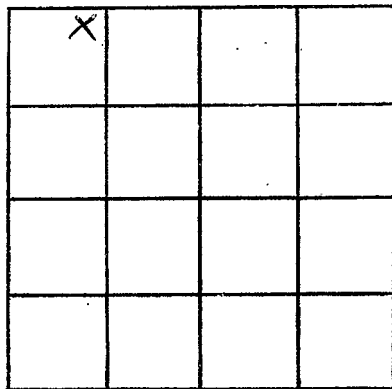

SECTION 10

Please indicate well location X.

ADDITIONAL INFORMATION

If more than one screen,
show locations of each on sketch.