

MONROE

K 64

8-13-73

MISSISSIPPI
 BOARD OF WATER COMMISSIONERS
 416 North State Street
 Jackson, Mississippi 39201

WATER WELL DRILLERS LOG

CODED

8/15 1973
date well completed

Herman Homan Well & Supply, Inc.
P.O. Box 42

MONROE
county well located

SHANNON, MISSISSIPPI 38 68

LANDOWNER:

Myland Jones
Rt 3 Aberdeen Miss
(mailing address)

description of formations encountered

from

to

| | | |
|--------------|-----|-----|
| Surface sand | 0 | 28 |
| 1/2 clay | | |
| Blue clay | 28 | 220 |
| Shale | 220 | 360 |
| Bottom | 360 | |

WELL LOCATION:

sec. 13 T. 19 N R. 6 E
2 miles SW of Aberdeen
(distance) (direction) (nearest town)

WELL PURPOSE:

(home, irrigation, municipal, industrial)
Home

WELL COMPLETION DATA:

- (1) diameter (inches) 5 1/4
- (2) total depth (feet) 360
- (3) static water level (feet) 76' below top of ground
- (4) casing steel 42' 4 1/4 (material) (depth)
8 1/4 (size) if telescope see back.
- (5) screen 20 (length) (depth to top)
(size) (material)
- (6) pump 1/2 (HP) 8 (yield gpm)
electric (type power)
- (7) electric log 20 (yes or no)
(organization running log)
- (8) how well bottom plugged Open

CODED


SEP 4 1973

DRILLERS REMARKS:

MISS. BD. OF
WATER COMM.

If well telescopes please sketch and show depths.

GROUND LEVEL

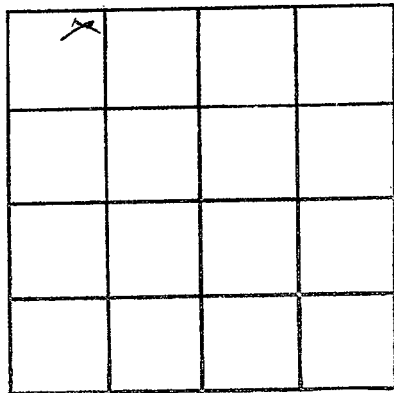

SECTION 13

Please indicate well location X.

ADDITIONAL INFORMATION

If more than one screen, show locations of each on sketch.