

MONROE  
K65  
8-26-73

MISSISSIPPI  
BOARD OF WATER COMMISSIONERS  
416 North State Street  
Jackson, Mississippi 39201

WATER WELL DRILLERS LOG

CODED

8/29 1973 Herman Homan Well & Supply, Inc. Monroe  
date well completed 1973 Herman Homan Monroe  
county well located

SHANNON, MISSISSIPPI 38668

LANDOWNER: Mrs. Ceco Jordan  
Erskine McAlister  
Rt 2 Aberdeen Miss  
(mailing address)

description of formations encountered	from	to
Surface sand & clay	0	20
Blue clay	20	160
Sand	160	300
Bottom	300	

WELL LOCATION:  
sec. 10 T. 19 N. R. 6 E.  
5 miles NW of Aberdeen  
(distance) (direction) (nearest town)

WELL PURPOSE: Home  
(home, irrigation, municipal, industrial)

- WELL COMPLETION DATA:
- (1) diameter (inches) 5"
  - (2) total depth (feet) 300
  - (3) static water level (feet) 85' below top of ground
  - (4) casing Steel, 3.5" x 4'  
(material) (depth)  
5" if telescope see back.  
(size)
  - (5) screen ND,   
(length) (depth to top)  
(size) (material)
  - (6) pump 1, 4  
(HP) (yield gpm)  
Electric  
(type power)
  - (7) electric log NO  
(yes or no)  
(organization running log)
  - (8) how well bottom plugged open

CODED


SEP 17 1973

DRILLERS REMARKS:

MISS. BD. OF  
WATER COMMISSIONERS

If well telescopes please sketch and show depths.

GROUND LEVEL

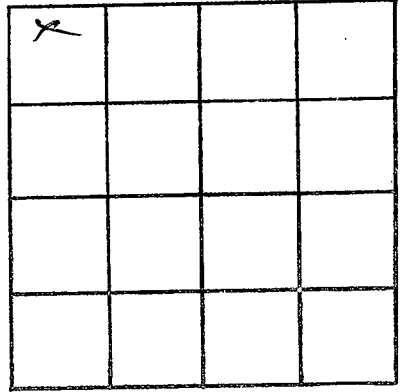

SECTION 10

Please indicate well location X.

ADDITIONAL INFORMATION

If more than one screen, show locations of each on sketch.