

MONROE

K 54 66

8-20-73

MISSISSIPPI BOARD OF WATER COMMISSIONERS 416 North State Street Jackson, Mississippi 39201

WATER WELL DRILLERS LOG

CODED

8-20-

1973

Leopard Drilling Co. Monroe

date well completed

firm name

county well located

LANDOWNER:

Frank Gillispie

R3 - Aberdeen, Miss (mailing address)

description of formations encountered

Black Clay
Chalk Rock
Chalk Rock
Rock & Sand

from	to
0	20
20	120
120	180
180	285

WELL LOCATION:

sec. 21 T 14 N R 6 E

miles (distance) of (direction) (nearest town)

WELL PURPOSE: Home (home, irrigation, municipal, industrial)

WELL COMPLETION DATA:

- (1) diameter (inches) 4
- (2) total depth (feet) 285
- (3) static water level (feet) 80 below top of ground
- (4) casing Steel 84 (material) (depth)
- (5) screen none (length) (depth to top)
- (6) pump 3/4 (HP) 10 (material) (yield gpm)
- (7) electric log no- (yes or no)
- (8) how well bottom plugged open


CODED

DRILLERS REMARKS:

MISS. 22 01

If well telescopes please sketch and show depths.

GROUND LEVEL

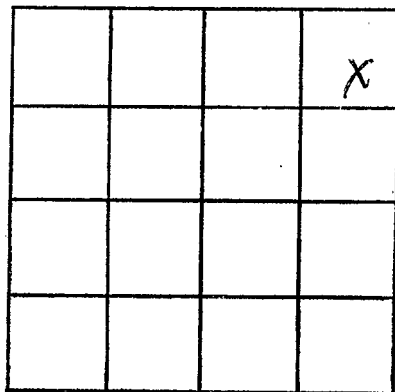

SECTION 21

Please indicate well location X.

ADDITIONAL INFORMATION

If more than one screen,
show locations of each on sketch.