

MONROE
K 68
11-19-73

MISSISSIPPI
BOARD OF WATER COMMISSIONERS
416 North State Street
Jackson, Mississippi 39201

CODED

WATER WELL DRILLERS LOG

Herman Homan Well & Supply, Inc.

11-19-73
date well completed

P. O. Box 42
firm name

SHANNON, MISSISSIPPI 38868

Monroe
county well located

LANDOWNER:

John D. James
Rt 5, Aberdeen Miss
(mailing address)

description of formations
encountered

	from	to
Surface clay	0	26
Blue clay	26	160
Sand	160	300
Bottom	300	

WELL LOCATION:

sec. 13 T 14 N R 6 E
2 1/2 miles N W of Aberdeen
(distance) (direction) (nearest town)

WELL PURPOSE:

Home
(home, irrigation, municipal, industrial)

WELL COMPLETION DATA:

- (1) diameter (inches) 5"
- (2) total depth (feet) 300'
- (3) static water level (feet) 76' below top of ground.
- (4) casing Steel (material), 3 1/2" (depth), 5' (size) if telescope see back.
- (5) screen ND (length), (depth to top) (size) (material)
- (6) pump ND (HP), (yield gpm) (type power)
- (7) electric log ND (yes or no) (organization running log)
- (8) how well bottom plugged open


CODED

DRILLERS REMARKS:

MISS. BD. OF
WATER COMMISSIONERS

If well telescopes please sketch and show depths.

GROUND LEVEL

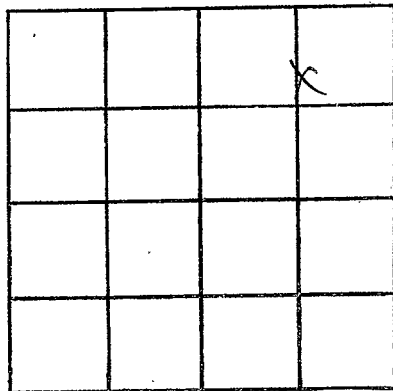

SECTION 13

Please indicate well location X.

ADDITIONAL INFORMATION

If more than one screen, show locations of each on sketch.