

MONROE  
K 70  
4-11-74

MISSISSIPPI  
BOARD OF WATER COMMISSIONERS  
416 North State Street  
Jackson, Mississippi 39201

WATER WELL DRILLERS LOG

4-11-74 1974 Herman Homan Well & Supply, Inc.  
date well completed firm name

Monroe  
county well located

P.O. BOX 42  
SHANNON, MISSISSIPPI 38868

LANDOWNER:

John R. McCollum  
A/S, Aberdeen Miss  
(mailing address)

description of formations encountered

Surface clay 0 to 16  
Silt & clay 16 to 169  
Sand 169 to 280  
Gravel 280 to

from to

WELL LOCATION:

sec. 11 T. 14 N R. 6 E  
3 1/2 miles N of Aberdeen  
(distance) (direction) (nearest town)

WELL PURPOSE: Home  
(home, irrigation, municipal, industrial)

WELL COMPLETION DATA:


- (1) diameter (inches) 5"
- (2) total depth (feet) 280'
- (3) static water level (feet) 81' below top of ground.
- (4) casing (material) steel, (depth) 21' 4"
- (5) screen (size) 5 (length) 10 (depth to top) (material) 5 (yield gpm)
- (6) pump (HP) electric (type power)
- (7) electric log NO (yes or no)

CODED

(organization running log)

(8) how well bottom plugged open

DRILLERS REMARKS:

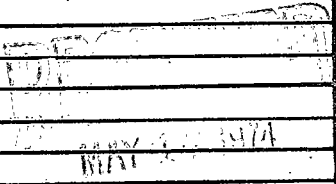

MISSISSIPPI BOARD OF WATER COMMISSIONERS  
STATE OF MISSISSIPPI

If well telescopes please sketch and show depths.

GROUND LEVEL

			X

SECTION 11

Please indicate well location X.

ADDITIONAL INFORMATION

If more than one screen,  
show locations of each on sketch.