

MONROE

K 71

4-29-74

MISSISSIPPI BOARD OF WATER COMMISSIONERS

416 North State Street

Jackson, Mississippi 39201 CODED

WATER WELL DRILLERS LOG

Herman Homan Well & Supply, Inc.

Monroe

4/29 1974 date well completed

P.O. Box 42 SHANNON, MISSISSIPPI 38608

county well located

LANDOWNER: R E NAIWY

description of fomations encountered

from

to

Hanna's Builders

2-1/2" sand

0 30

Okeolona Miss. (mailing address)

+ clay clay Blue clay

30 140

WELL LOCATION:

sec. 4 T 19 N R 6 E S W of Aberdeen (distance) (direction) (nearest town)

Sand Bottom

140 280 280

WELL PURPOSE: Home (home, irrigation, municipal, industrial)

WELL COMPLETION DATA:


- (1) diameter (inches) 5 1/4
(2) total depth (feet) 280
(3) static water level (feet) 102' below top of ground.
(4) casing Steel, 42' 5 1/4 (material) (depth) 5 1/4 (size) If telescope see back.
(5) screen no, (length) (depth to top)
(6) pump 1/2 HP electric (type power) (yield gpm)
(7) electric log no (yes or no)
(8) how well bottom plugged open

CODED

DRILLERS REMARKS:

If well telescopes please sketch and show depths.

GROUND LEVEL

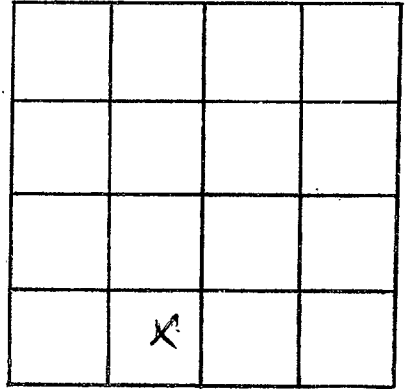

SECTION f

Please indicate well location X.

ADDITIONAL INFORMATION

If more than one screen,
show locations of each on sketch.