

**MONROE**  
**K 72**  
**9/14/74**

**MISSISSIPPI**  
**BOARD OF WATER COMMISSIONERS**  
 416 North State Street  
 Jackson, Mississippi 39201 **CODED**

**WATER WELL DRILLERS LOG**

Herman Homan Well & Supply, Inc.  
 P. O. Box 12  
 SHANNON, MISSISSIPPI 38668

9/14 1974 date well completed  
 firm name  
 county well located

**LANDOWNER:** *contractor*  
 David Holliday  
 Rt 2 A Kolona, Miss.  
 (mailing address)

description of formations encountered	from	to
Surface clay	0	17
to the clay	17	220
Sand	220	360
Bottom	360	

**WELL LOCATION:**  
 sec. 9 T 19 N R 6 E  
 S  
 5 1/2 miles N of Prairie  
 (distance) (direction) (nearest town)

**WELL PURPOSE:** *Home*  
 (home, irrigation, municipal, industrial)


- WELL COMPLETION DATA:**
- (1) diameter (inches) 5"
  - (2) total depth (feet) 360'
  - (3) static water level (feet) 84' below top of ground.
  - (4) casing steel (material) 2 1/4" (depth)  
5 if telescope see back. (size)
  - (5) screen NO (length) (depth to top)  
 (size) (material)
  - (6) pump 1/2 (HP) 5 (yield gpm).  
electric (type power)
  - (7) electric log NO (yes or no)  
 (organization running log)
  - (8) how well bottom plugged open

**DRILLERS REMARKS:**

**RECEIVED**  
**SEP 17 1974**  
**MISS. Bd. of WATER COMMISSIONERS**

If well telescopes please sketch and show depths.

GROUND LEVEL

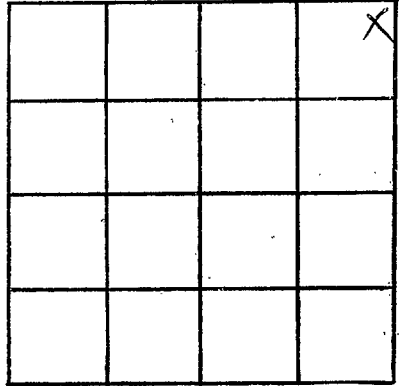

SECTION 9

Please indicate well location X.

ADDITIONAL INFORMATION

If more than one screen, show locations of each on sketch.