

MONROE
K 73
4-17-75

MISSISSIPPI
BOARD OF WATER COMMISSIONERS
416 North State Street
Jackson, Mississippi 39201

CODED

WATER WELL DRILLERS LOG

Herman Homan Well & Supply, Inc.

Monroe

4/17 1975
date well completed

SHANNON, MISSISSIPPI 38688


county well located

LANDOWNER:	description of formations encountered	from	to
Willy Boyd Gathings Rt 2, Okolona, Miss (mailing address)	surface clay Bath clay Sand Bath	0 16 260 700	16 260 (260)
WELL LOCATION: sec 31 T 14 N R 6 E S W 2 miles SW of Gibson (distance) (direction) (nearest town)			
WELL PURPOSE: Home (home, irrigation, municipal, industrial)			
WELL COMPLETION DATA:			
(1) diameter (inches) 4 1/2"			
(2) total depth (feet) 400'			
(3) static water level (feet) 105' below top of ground.			
(4) casing steel, 21', (material) (depth) 9" If telescope see back. (size)			
(5) screen no, (depth to top)			
(size) (material)			
(6) pump 1/2 (HP) 5 (yield gpm)			
electron (type power)			
(7) electric log no (yes or no)			
(organization running log)			
(8) how well bottom plugged open			
DRILLERS REMARKS:			

RECEIVED
MAY 19 1975

If well telescopes please sketch and show depths.

GROUND LEVEL

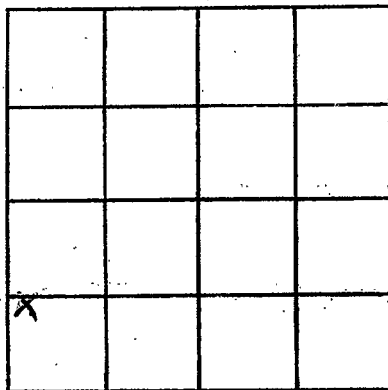

SECTION 31

Please indicate well location X.

ADDITIONAL INFORMATION

If more than one screen,
show locations of each on sketch.