

MONROE
K 74
9-16-75

MISSISSIPPI
BOARD OF WATER COMMISSIONERS
416 North State Street
Jackson, Mississippi 39201

CODED

WATER WELL DRILLERS LOG

1975 4/16 Herman Homan Well & Supply, Inc. *Monroe*
 (date well completed) firm name BOX 42 county well located
 SHANNON, MISSISSIPPI 38668

LANDOWNER:	description of formations encountered	from	to
Willy B. Chandler et al, Aberdeen, Miss (mailing address)			

WELL LOCATION:
 sec. 9 T. 14 N. R. 6 E.
 S. NE of Gibson
 (distance) (direction) (nearest town)

WELL PURPOSE: *Home*
 (home, irrigation, municipal, industrial)

- WELL COMPLETION DATA:
- (1) diameter (inches) 4"
 - (2) total depth (feet) 360'
 - (3) static water level (feet) 134' below above top of ground
 - (4) casing steel, 21 1/2'
 (material) (depth)
4" if telescope see back.
 (size)
 - (5) screen NO,
 (length) (depth to top)
 (size) (material)
 - (6) pump 1/2 5
 (HP) (yield gpm)
electric
 (type power)
 - (7) electric log NO
 (yes or no)
 (organization running log)
 - (8) how well bottom plugged open


DRILLERS REMARKS:

RECEIVED
MAY 19 1975

MISS. Bd. OF WATER COMMISSIONERS

If well telescopes please sketch and show depths.

GROUND LEVEL

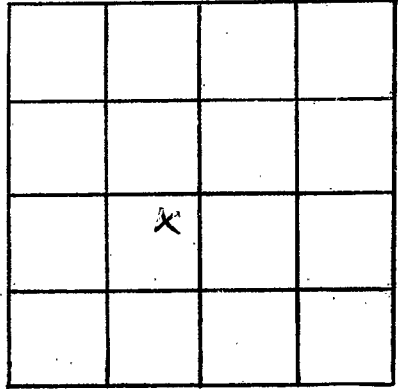

SECTION 9

Please indicate well location X.

ADDITIONAL INFORMATION

If more than one screen,
show locations of each on sketch.