

Monroe
K 75
8-5-75

MISSISSIPPI
BOARD OF WATER COMMISSIONERS
416 North State Street
Jackson, Mississippi 39201

CODED

WATER WELL DRILLERS LOG

8/5 1975 Herman Homan Well & Supply, Inc. Monroe
date well completed firm on Box 42 county well located

LANDOWNER: SWISS AMERICAN FRONTS description of formations encountered from to
PO BOX 761, Aberdeen, Miss. Blue clay 0 35
(mailing address) Sand 35 60
Bath 60 300


WELL LOCATION:
sec 22 T 14 N R 6 E 13 L
1 1/2 miles F of Gibson
(distance) (direction) (nearest town)

WELL PURPOSE: FAVAN
(home, irrigation, municipal, industrial)

- WELL COMPLETION DATA:
- (1) diameter (inches) 4 1/2
 - (2) total depth (feet) 300
 - (3) static water level (feet) below above top of ground
 - (4) casing steel 4 1/2" 300'
(material) (depth)
4" If telescope see back.
(size)
 - (5) screen NO
(length) (depth to top)
(size) (material)
 - (6) pump NO
(HP) (yield gpm)
(type power)
 - (7) electric log NO
(yes or no)
(organization running log)
 - (8) how well bottom plugged open

CODED


DRILLERS REMARKS:

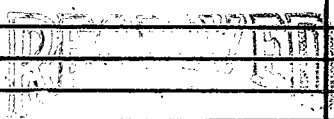

AUG 18 1975

If well telescopes please sketch and show depths.

GROUND LEVEL

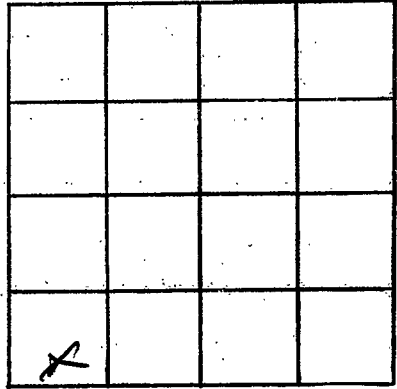

SECTION 22

Please indicate well location X.

ADDITIONAL INFORMATION

If more than one screen,
show locations of each on sketch.