

MONROE
K 78
12/1/77

MISSISSIPPI
BOARD OF WATER COMMISSIONERS
416 North State Street
Jackson, Mississippi 39201

CODED

WATER WELL DRILLERS LOG

12/1/77 19 Given Drilling Service Monroe
date well completed firm name county well located

LANDOWNER: Louisiana Land

description of formations encountered

from

to

Exploration

#2 Lee H. Harrington
(mailing address)

Hard Clay	0	21
Hard Clay	22	43
Hard Clay	43	63
Stratified Sand Clay	64	360

WELL LOCATION: SE, SE
sec 25, T 14 N, R 6 E
1000' + 660' W of S of SE cor of Gibson
(distance) miles (direction) of (nearest town)

WELL PURPOSE:
(home, irrigation, municipal, industrial)

WELL COMPLETION DATA:

- (1) diameter (inches) 3"
- (2) total depth (feet) 360'
- (3) static water level (feet) 70 ^{below} _{above} top of ground.
- (4) casing steel, 225
(material) (depth)
- (size) if telescope see back.
- (5) screen (length) (depth to top)
- (size) (material)
- (6) pump 70
(HP) (yield gpm)
- AC
(type power)
- (7) electric log NO
(yes or no)
- (organization running log)

(8) how well bottom plugged open
ended

DRILLERS REMARKS:
Jackie Starkey


CODED

RECEIVED
DEC 5 1977

MISS. BD. OF WATER COMM.

If well telescopes please sketch and show depths.

GROUND LEVEL

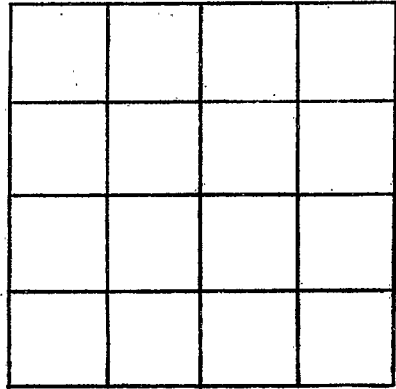

SECTION _____

Please indicate well location X.

ADDITIONAL INFORMATION

If more than one screen, show locations of each on sketch.