

MONROE
K 79
1/25/78

MISSISSIPPI
BOARD OF WATER COMMISSIONERS
416 North State Street
Jackson, Mississippi 39201

0003

WATER WELL DRILLERS LOG

1/25/78 19 Green Drilling Service Monroe
date well completed firm name county well located

LANDOWNER: Par
Exploration
T. D. Millender #1
(mailing address)

description of formations encountered	from	to
Chalk & hard Rocks	0	336
Streaked in Places	337	378
Clay & Rocks	379	411
Streaked	442	462
Chalk	463	483
mostly Sand	484	505
Chalk	506	567
Streaked in Places but mostly Chalk & Rocks	568	714

WELL LOCATION:
sec. 20 T 14 N R. 6 E
(S) (W)
4 1/2 miles West of Abbeville
(distance) (direction) (nearest town)

WELL PURPOSE:
(home, irrigation, municipal, industrial)

WELL COMPLETION DATA:

(1) diameter (inches) 3"

(2) total depth (feet) 714

(3) static water level (feet) 120 below above top of ground.

(4) casing Steel 480'
(material) (depth)
3" if telescope see back.
(size)

(5) screen 40 440'
(length) (depth to top)
3/4" Perforated Pipe
(size) (material)

(6) pump 70
(HP) (yield gpm)
AC
(type power)

(7) electric log NO
(yes or no)
(organization running log)


(8) how well bottom plugged Orange
Peel

RECEIVED
FEB 10 1978

DRILLERS REMARKS:
Randy Lewis

If well telescopes please sketch and show depths.

GROUND LEVEL

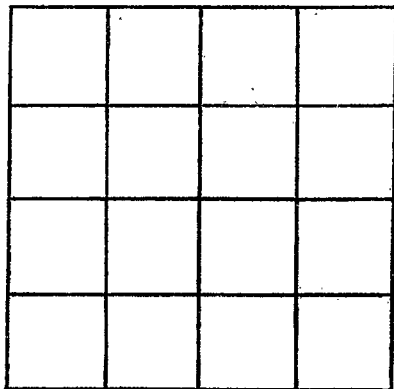

SECTION _____

Please indicate well location X.

ADDITIONAL INFORMATION

If more than one screen,
show locations of each on sketch.