

MISSISSIPPI DEPARTMENT OF NATURAL RESOURCES

Bureau of Land and Water Resources

Southport Mall

P.O. Box 10631

Jackson, Mississippi 39209

CODED

WATER WELL DRILLERS LOG

Griner Drilling Service, INC.

Monroe

MONROE
K 80
11/9/81

11-9-81 date well completed

Griner Drilling Service, INC. firm name

Monroe county well located

LANDOWNER:	description of formations encountered	from	to
Spooner Petroleum 111 Capitol Bldg. Suite 360 Jackson, MS address 39201	clay + rock	0	455
WELL LOCATION: 1650' N of 1550' E sec 32 T 14 N R 6E SW 1/4 Evans #1 Sawyer #1 Drainie	sand	455	476
(distance) miles (direction) of (nearest town)	clay + rock	476	682
WELL PURPOSE: oil field supply (home, irrigation, municipal, industrial)			
WELL COMPLETION DATA: (1) diameter (inches) 3" (2) total depth (feet) 682' (3) static water level (feet) 100' 66low above top of ground. (4) casing steel 483' (material) (depth) 3" (size) if telescope see back. (5) screen 42' 481' (length) (depth to top) 3" perforated (size) (material) (6) pump — 75 (HP) (yield gpm) AC (type power) (7) electric log — (yes or no) (organization running log) (8) how well bottom plugged orange peel			
DRILLERS REMARKS:			


CODED

DEPT. OF NATURAL RESOURCES
BUREAU OF LAND & WATER RESOURCES

DEC-9 1981
RECEIVED

If well telescopes please sketch and show depths.

GROUND LEVEL

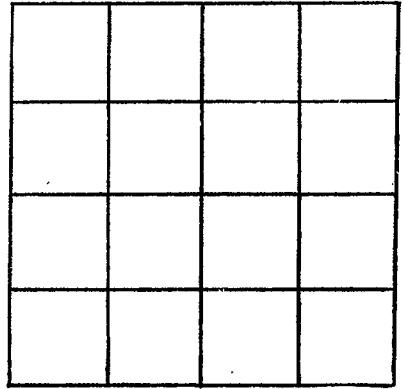

SECTION _____

Please indicate well location X.

ADDITIONAL INFORMATION

If more than one screen, show locations of each on sketch.