

MISSISSIPPI DEPARTMENT OF NATURAL RESOURCES

Bureau of Land and Water Resources

Southport Mall

P.O. Box 10631

Jackson, Mississippi 39209

WATER WELL DRILLERS LOG

CODED

K81
 MONROE
 7-10-84

7-10-84
 date well completed

Griner Drilling Service, INC.
 firm name

MONROE
 county well located

LANDOWNER:	description of formations encountered	from	to
TXO Production Suite 555 141 Capital Bldg. Jackson, Miss. address 39201	streaked clay, rock	0	200
WELL LOCATION: 1650' S + 990' E T 27 N R 6 E NW 1/4	streaked sand, clay	200	360
Abberdeen	SAND	360	375
	hard clay	375	444
WELL PURPOSE: <u>Oilfield supply</u> (home, irrigation, municipal, industrial)			
WELL COMPLETION DATA:			
(1) diameter (inches) <u>3"</u>			
(2) total depth (feet) <u>420'</u>			
(3) static water level (feet) <u>80'</u> <u>below</u> above top of ground.			
(4) casing <u>Steel</u> <u>294'</u> (material) (depth) <u>3"</u> (size) If telescope see back.			
(5) screen <u>OPEN ENDED</u> (length) (depth to top)			
(6) pump <u>NIP</u> <u>75</u> (HP) (yield gpm) <u>AC</u> (type power)			
(7) electric log <u>—</u> (yes or no) <u>—</u> (organization running log)			
(8) how well bottom plugged <u>orange peel</u>			
DRILLERS REMARKS:			


DEPT. OF NATURAL RESOURCES
 BUREAU OF LAND & WATER RESOURCES

JUL 26 1984

RECEIVED

If well telescopes please
sketch and show depths.

GROUND LEVEL

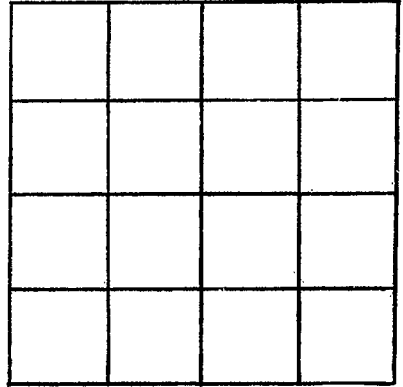

SECTION _____

Please indicate well location X.

ADDITIONAL INFORMATION

If more than one screen,
show locations of each on sketch.