

MISSISSIPPI DEPARTMENT OF NATURAL RESOURCES

Bureau of Land and Water Resources

Southport Mall

P.O. Box 10631

Jackson, Mississippi 39209

WATER WELL DRILLERS LOG

CODED

MONROE
R 82

Griner Drilling Service, Inc.

Monroe

10-25-84
date well completed

Griner Drilling Service, Inc.
firm name

Monroe
county well located

LANDOWNER:
Pruet Production Co.
217 West Capitol St.
Suite 201
Jackson, MS 39201
(mailing address)

description of formations encountered	from	to
clay	0	294
streaked sand	294	315
clay, rock, sand	315	400
sand	400	438
clay	438	441

WELL LOCATION: 2000'S & 1500' W
sec. 22 T. 14 N R. 6 E of
NO. 1 Sawyer 32.7 miles Gibson WELCOR
(distance) (direction) (nearest town)

WELL PURPOSE: oil field supply
(home, irrigation, municipal, industrial)

CODED

- WELL COMPLETION DATA:
- (1) diameter (inches) 3"
 - (2) total depth (feet) 441'
 - (3) static water level (feet) 80 below above top of ground.
 - (4) casing steel 341'
(material) (depth)
3" if telescope see back.
(size)
 - (5) screen 42' 399'
(length) (depth to top)
3" perforated
(size) (material)
 - (6) pump - 75
(HP) (yield gpm)
AC
(type power)
 - (7) electric log (yes of no)

(organization running log)
 - (8) how well bottom plugged Orange peel

DEPT. OF NATURAL RESOURCES
BUREAU OF LAND & WATER RESOURCES


NOV 14 1984

RECEIVED

DRILLERS REMARKS:

If well telescopes please
sketch and show depths.

GROUND LEVEL

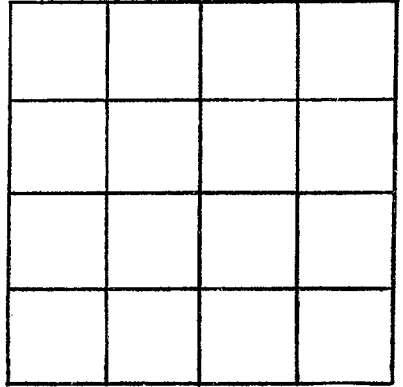

SECTION _____

Please indicate well location X.

ADDITIONAL INFORMATION

If more than one screen,
show locations of each on sketch.