

STATE WELL REPORT

Part 1

Driller's Log

Mississippi Department of Environmental Quality
Office of Land and Water Resources
P.O. Box 2309
Jackson, MS 39225-2309
(601)961-5210
(601)360-0535 (fax)

For Office Use Only:

Well #: _____
Aquifer: K90
E-Log #: _____

County: Monroe
Permit #: MS-GW-17064
Driller: Donald Smith Co., Inc
Date drilling completed: 4/2013

State Law requires that this report be prepared by the license holder responsible for the work and filed with the Department at the above address within 30 days of completion of drilling of the well or borehole.

Well Owner Information <small>(Landowner if borehole is not for a water well)</small>	Well or Borehole Location
Owner Name: <u>T & D Farms</u>	Latitude: <u>33 50 23N</u> Longitude: <u>88 38 59W</u>
Mailing Address: <u>% Tony Kelly</u>	Method of Lat/Long (check one): Conventional Survey _____, USGS quad _____, Hand-held GPS <u>X</u> , Survey-grade GPS _____
<u>20403 Hwy 8 West</u>	SE ^{NE} 1/4 SW ^{NE} 1/4, Sec <u>27</u> T <u>14S</u> R <u>06E</u>
<u>Aberdeen</u> MS <u>39730</u>	<u>4 1/2</u> Miles <u>West</u> of <u>Aberdeen, MS</u>
City State Zip Code	(Distance) (Direction) (Nearest Town)
Telephone No. <u>(731) 780-2311</u>	

Well / Borehole Data
Date drilling started: <u>3/14/13</u> Date drilling completed: _____ Hole depth: <u>786'</u> Hole diameter: <u>17 3/4"</u>
Location of the source of any surface water used for drilling: <u>Public Water Supply</u>
Method of dosing and volume of Chlorine used in drilling and development: <u>Potable Water used</u>
Logs run (circle all applicable): No log run <input checked="" type="checkbox"/> Electric <input type="checkbox"/> Gamma Ray <input type="checkbox"/> Density <input type="checkbox"/> Sonic <input type="checkbox"/> Neutron <input type="checkbox"/> Other: _____
Name of organization running log(s): <u>State of MS Office of Geology</u>
Purpose of borehole (circle one): <input checked="" type="checkbox"/> Water Well <input type="checkbox"/> Geotechnical/Geological Investigation <input type="checkbox"/> Ground Source Heat Pump
Seismic Survey <input type="checkbox"/> Other (describe) _____
<i>If drilling is not related to water well construction, skip the remainder of this block</i>

Purpose of Well (circle all applicable): Home <input type="checkbox"/> Industrial <input type="checkbox"/> Public Supply <input type="checkbox"/> <input checked="" type="checkbox"/> Irrigation <input type="checkbox"/> Fish Culture
Other (describe): _____
If a flowing well, method of flow regulation: Valve <u>N/A</u> Other (describe) <u>N/A</u>
Static Water Level: <u>60</u> feet [above or <input checked="" type="checkbox"/> below] land surface Date measured: _____ <small>(circle one)</small>
Method of measurement (circle one): Steel tape <input checked="" type="checkbox"/> Electric tape <input type="checkbox"/> Air line <input type="checkbox"/> Other (describe): _____
Well depth: <u>725</u> Well grouted to a depth of: <u>100</u> feet Type of grout (circle one): <input checked="" type="checkbox"/> Neat Cement <input type="checkbox"/> Bentonite <input type="checkbox"/> Mix
Casing length: <u>585</u> feet Casing diameter: <u>10</u> inches Type of casing: <u>Steel</u>
Screen length: <u>80</u> feet Screen diameter: <u>8</u> inches Type of screen: <u>SS</u>
Screen slot size: <u>.025</u> inches Setting depth: From <u>645</u> feet to <u>725</u> feet
Type of completion (circle all applicable): <input checked="" type="checkbox"/> Gravel packed <input type="checkbox"/> Underreamed <input type="checkbox"/> Open hole <input type="checkbox"/> Natural Development
Other (describe): <u>10/20 Gravel</u>
Top of lap pipe or reduction in casing: <u>585</u> feet
<i>If telescoped or more than one screen, describe on next page</i>

RECEIVED

APR 26 2013


BY: OLWR

County: Monroe
 Permit #: MS-GW-17064

For Office Use Only:
 Well #: _____

The sketch below only required for water wells

If well telescopes, show depths on sketch.

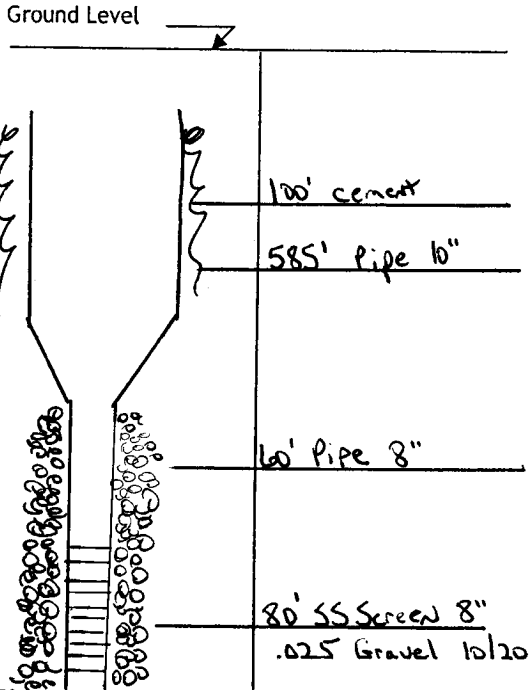


If more than one screen, show location of each on sketch

Description of formations encountered must be provided for all wells and boreholes, unless specifically exempted by regulations

Description of Formations Encountered	From (depth) Ground level	To (depth)
Brown Clay	0	20
Blue Clay	20	144
Shell	144	145
Blue Clay & Sand Streaks	145	245
Sand/Blue Clay Streaks	245	280
Blue Sand	280	330
Shell	330	332
Sand/Clay Streaks	332	424
Shell	424	425
Clay & Sand Strks	425	525
Gray Sand & Clay Strks	525	560
Blue Clay	560	580
Gray Sand	580	605

Sketch the property layout and include the following:

- 1) the well location
- 2) any permanent structures on the property that may aid in locating the well
- 3) any roads, power lines, or other items that may aid in locating the property and the well
- 4) north arrow

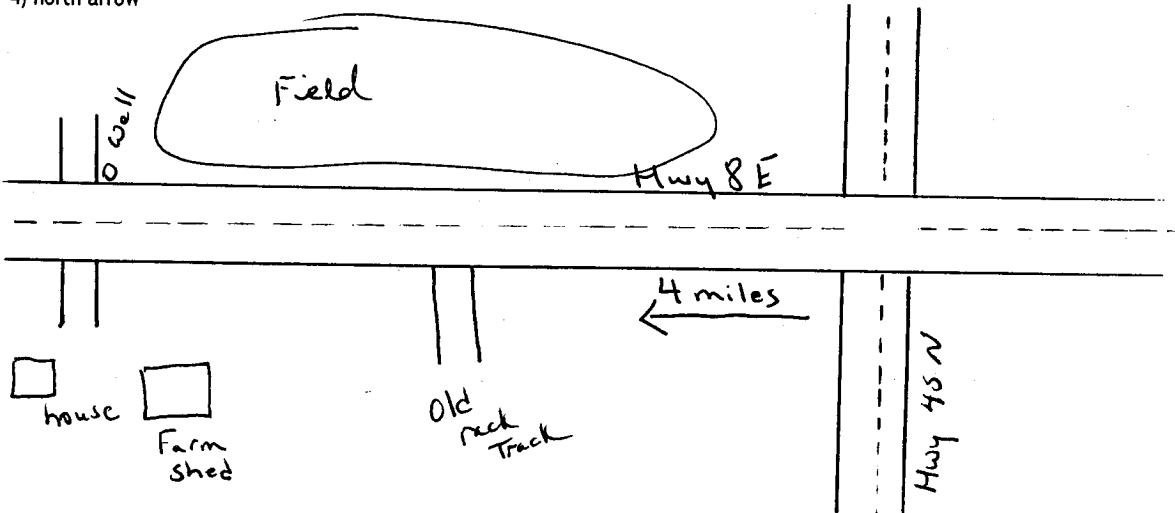

Landowner Name: _____

I HEREBY CERTIFY that the well/borehole was drilled, constructed, and completed in accordance with all applicable requirements of the Mississippi Department of Environmental Quality and the Mississippi Department of Health regulations, if applicable, and state laws.

Robert L. Young, Jr. 00005671
 Print Name of Responsible Licensee and License No.

4/22/13
 Date

Robert Young Jr
 Signature of Licensee

STATE WELL REPORT

Part 2

Pump Installer's Completion Report
 Mississippi Department of Environmental Quality
 Office of Land and Water Resources
 P.O. Box 2309
 Jackson, MS 39225-2309
 (601)961-5210
 (601) 360-0535 (fax)

County: Monroe
 Permit #: MS-GW-17064
 Driller: Donald Smith Co., Inc
 Date completed: 7/3/13
Copy information from block on Part 1

For Office Use Only:

Well #: K9C
 Aquifer: _____

This part of the report must be completed by a licensed water well contractor or a licensed pump installer. A copy of Part 1 of the report must be attached and both parts filed with the Department at the above address within 30 days of well completion.

Well Owner Information	Well Location
Owner Name: <u>T & O Farms</u>	Latitude: <u>33 50 23N</u> Longitude: <u>88 38 59W</u>
Mailing Address: <u>96 Tony Kelly</u>	Method of Lat/Long (check one): Conventional Survey _____,
<u>20403 Hwy 8 West</u>	USGS quad _____, Hand-held GPS <input checked="" type="checkbox"/> , Survey-grade GPS _____
<u>Aberdeen, MS 39730</u>	<u>SE</u> ¼ <u>SW</u> ¼, Sec <u>27</u> T <u>14S</u> R <u>06E</u>
City _____ State _____ Zip Code _____	<u>4 1/2</u> Miles <u>West</u> of <u>Aberdeen, MS</u>
Telephone No. (<u>731</u>) <u>780-2311</u>	(Distance) (Direction) (Nearest Town)

Pump Type (circle one)

Submersible Turbine Air Lift Centrifugal Flowing Well Jet Piston Rotary Other (describe): _____

Date Pump Installed: 6/25/13 Rated Pump Capacity: 750 Gallons Per Minute

Is This Pump (circle one): New Repaired Replacement

Power Type (circle one)

Electric Diesel Gasoline Natural Gas Tractor PTO Windmill Other (describe): _____

Horse Power Rating of Motor: 60 Setting Depth: 231 feet Number of Stages: 3

Pump Test Data for Non Flowing Well

Date Well Tested: 7/3/13 Duration of Pump Test (minimum 4 hours): 4 hours

Static Water Level (A): 59.3 Feet Below Land Surface Pumping Water Level (B): 144 Feet Below Land Surface

Drawdown [(B) - (A)]: 84.7 Feet Below Land Surface Test Pumping Rate: 752 Gallons Per Minute

Method of measurement (circle one): Steel tape Electric tape Air line Other (describe): _____

Pump Test Data for Flowing Well

Measured shut in head: _____ feet.

Well yielded _____ GPM with a drawdown of _____ feet after _____ hours of pumping

Meter Installation

Meter Manufacturer: N/A Meter Serial Number: _____

Meter Model Number/Name: _____ Type of Meter: _____

Totalizer Register Unit and Multiplier Factor (AF x .001, gal x 1000, etc): _____

Installation Date: _____ Meter installed by: _____

Is This Meter (circle one): New Repaired Replacement

RECEIVED
BY: BLW

Important: By submitting the above information you are certifying that this meter was installed to manufacturer standards. For agricultural wells, a list of approved meters is on the MDEQ website.

I HEREBY CERTIFY that the above statements are true to the best of my knowledge.

Robert L. Young, Jr. UNR-5671 7/19/13 Robert Young Jr
 Print Name of Pump Installer and License No. (if applicable) Date Signature of Pump Installer