

K

K 300

WATER WELL DRILLERS LOG

Herndon Well & Supply Co.

12-9-60

Date: 12/9, 1960, Driller: SHANNON, MISS. County MONROE

(Name)

(1) Owner of Land: Toby E. Larkes  
 (Name)  
Rt 1 Aberdeen Miss  
 (Address)

(2) Location: 1/4, 1/4, Sec. 4 T. 145 R. 66E  
7 miles NW, of Aberdeen  
 (distance) (direction) (Nearest Town)

(3) Topography: Flat  
 (Hilly) (Flat) (Level)

(4) Purpose of Well: Home Use  
 (Domestic Irrigation  
 Municipal, Industrial, Other)

Description & Color of Materials Sand, Clay, Red Clay, Shell, etc.	Thick- ness Feet	Depth Feet.
<u>sand &amp; clay</u>		<u>15</u>
<u>Blue Rock</u>		
<u>Rock</u>		<u>135</u>
<u>Blue Rock</u>		<u>135</u>
<u>sand</u>		<del>310</del>
<u>to</u>		
<u>bottom</u>		<u>310</u>

Information upon completion of well:

(1) Diameter 4 inches.

(2) Total Depth 310' feet.

(3) Water Level: 60 feet below top of ground.

(4) Cased to 21' 8", Size 4"


(5) Screen: Size     , Length     

(6) Were any formations sealed against pollution?  
 yes,  no.

If YES depth of formation 15'

Why Surface & sand

Drillers Remarks:

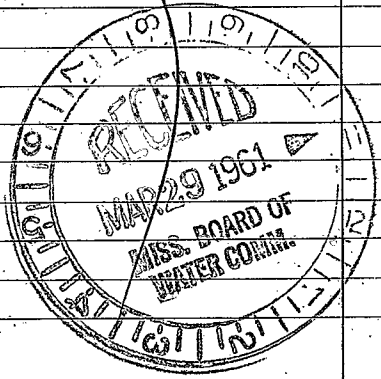

(Use Back Side)

Well 1

