

WATER WELL DRILLERS LOG

K 301

MONROE

Herndon Well & Supply Co.

Date: 3/4, 1961, Driller: SHANNON, MISS. County Monroe

K

(1) Owner of Land: 3-4-61 Jack Baker
(Name)
RT 1 Oklaona, Miss.
(Address)

(2) Location: 1/4, 1/4, Sec. 14 ¹⁴ ~~13~~ ⁶⁶ ~~65~~ ^R ~~R~~
5 miles NW, of Aberdeen
(distance) (direction) (Nearest Town)

(3) Topography: Flat
(Hilly) (Flat) (Level)

(4) Purpose of Well: Home Use
(Domestic Irrigation
Municipal, Industrial, Other)

Description & Color of Materials Sand, Clay, Red Clay, Shell, etc.	Thick- ness Feet	Depth Feet
SAND & CLAY		
Blue Shale		35
Rock	168	
SAND	170	
SAND	210	
Bottom	315	

Information upon completion of well:

(1) Diameter 4 inches.

(2) Total Depth 315 feet.

(3) Water Level 95 feet below top of ground.

(4) Cased to 39'8", Size 4


(5) Screen: Size _____, Length _____

(6) Were any formations sealed against pollution?
 yes, no.

If YES depth of formation 35 ft.

Why Surface & Sand

Drillers Remarks: _____

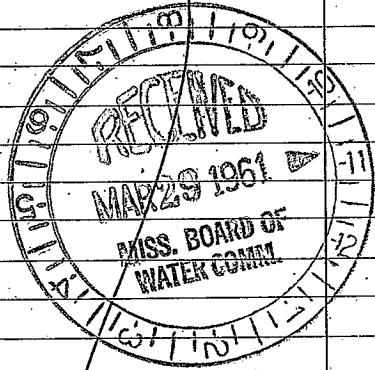

(Use Back Side)

Well No.

