

K

7-22-61

WATER WELL DRILLERS LOG

K302

HERNDON WELL & SUPPLY CO.

Date: 7-22, 1961, Driller: P.O. BOX 42 County Monroe

SHANNON, MISSISSIPPI

(1) Owner of Land:	Description & Color of Materials Sand, Clay, Red Clay, Shell, etc.	Thick- ness Feet	Depth Feet
(Name) 207 Jones Aberdeen, Miss (Address)	Surface sand & clay		0
(2) Location: 1/4, 1/4, Sec 19 T 145 R 6 E Gibson 10 miles West of Aberdeen (distance) (direction) (Nearest Town)	Blue silt sand	8	15 280
(3) Topography: Level (Hilly) (Flat) (Level)	Bottom	8	400
(4) Purpose of Well: Spmng. (Domestic Irrigation Municipal, Industrial, Other)			


Information upon completion of well:

- (1) Diameter 5 inches.
- (2) Total Depth 400 feet.
- (3) Water level 130 feet below top of ground.
- (4) Cased to 19'3", Size 5"
- (5) Screen: Size \_\_\_\_\_, Length \_\_\_\_\_
- (6) Were any formations sealed against pollution?  
 yes, \_\_\_\_\_ no.

If YES depth of formation 15'

Why Surface & sand

Drillers Remarks:

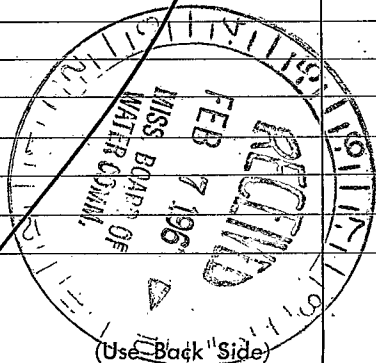

Well No.

